

FIGURED DIMENSIONS ONLY TO BE USED. DRAWINGS ARE NOT TO BE SCALED

ALL DIMENSIONS AND LEVELS ARE TO BE VERIFIED ON SITE PRIOR TO COMMENCING. SETTING OUT WORKSHOP DRAWINGS OR CONSTRUCTION

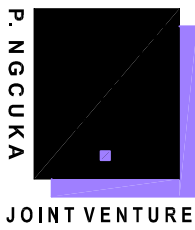
DISCREPANCIES, ERRORS AND OMISSIONS ARE TO BE BROUGHT TO THE ARCHITECT'S ATTENTION IMMEDIATELY THEY BECOME EVIDENT

SHAP DRAWINGS TO BE SUBMITTED FOR APPROVAL PRIOR TO MANUFACTURE OR INSTALLATION

COPYRIGHT AND RIGHT OF REPRODUCTION OF THIS DRAWING OR ANY PORTION THEREOF IS RESERVED BY THE ARCHITECTS

[illegible]

**Client**  
**EAST LONDON IDZ (PTY) LTD**



**OSMOND LANGE ARCHITECTS  
PLANNERS JOINT VENTURE**  
1ST FLOOR, 1101 MALL HOUSE, THE  
QUAYS, SALISBURY, EAST LONDON  
E1 6AB 721 8023  
P: 020 721 8028 E: [osl@osmondlange.com](mailto:osl@osmondlange.com)

**EAST LONDON INDUSTRIAL  
DEVELOPMENT ZONE  
ZONE 1A**

**CCA ADMINISTRATION  
SERVICE CENTRE  
BUILDING "A"**

Scale 1:50	Date 08.03.2004	Drawn XAB'S	Checked .
---------------	--------------------	----------------	--------------

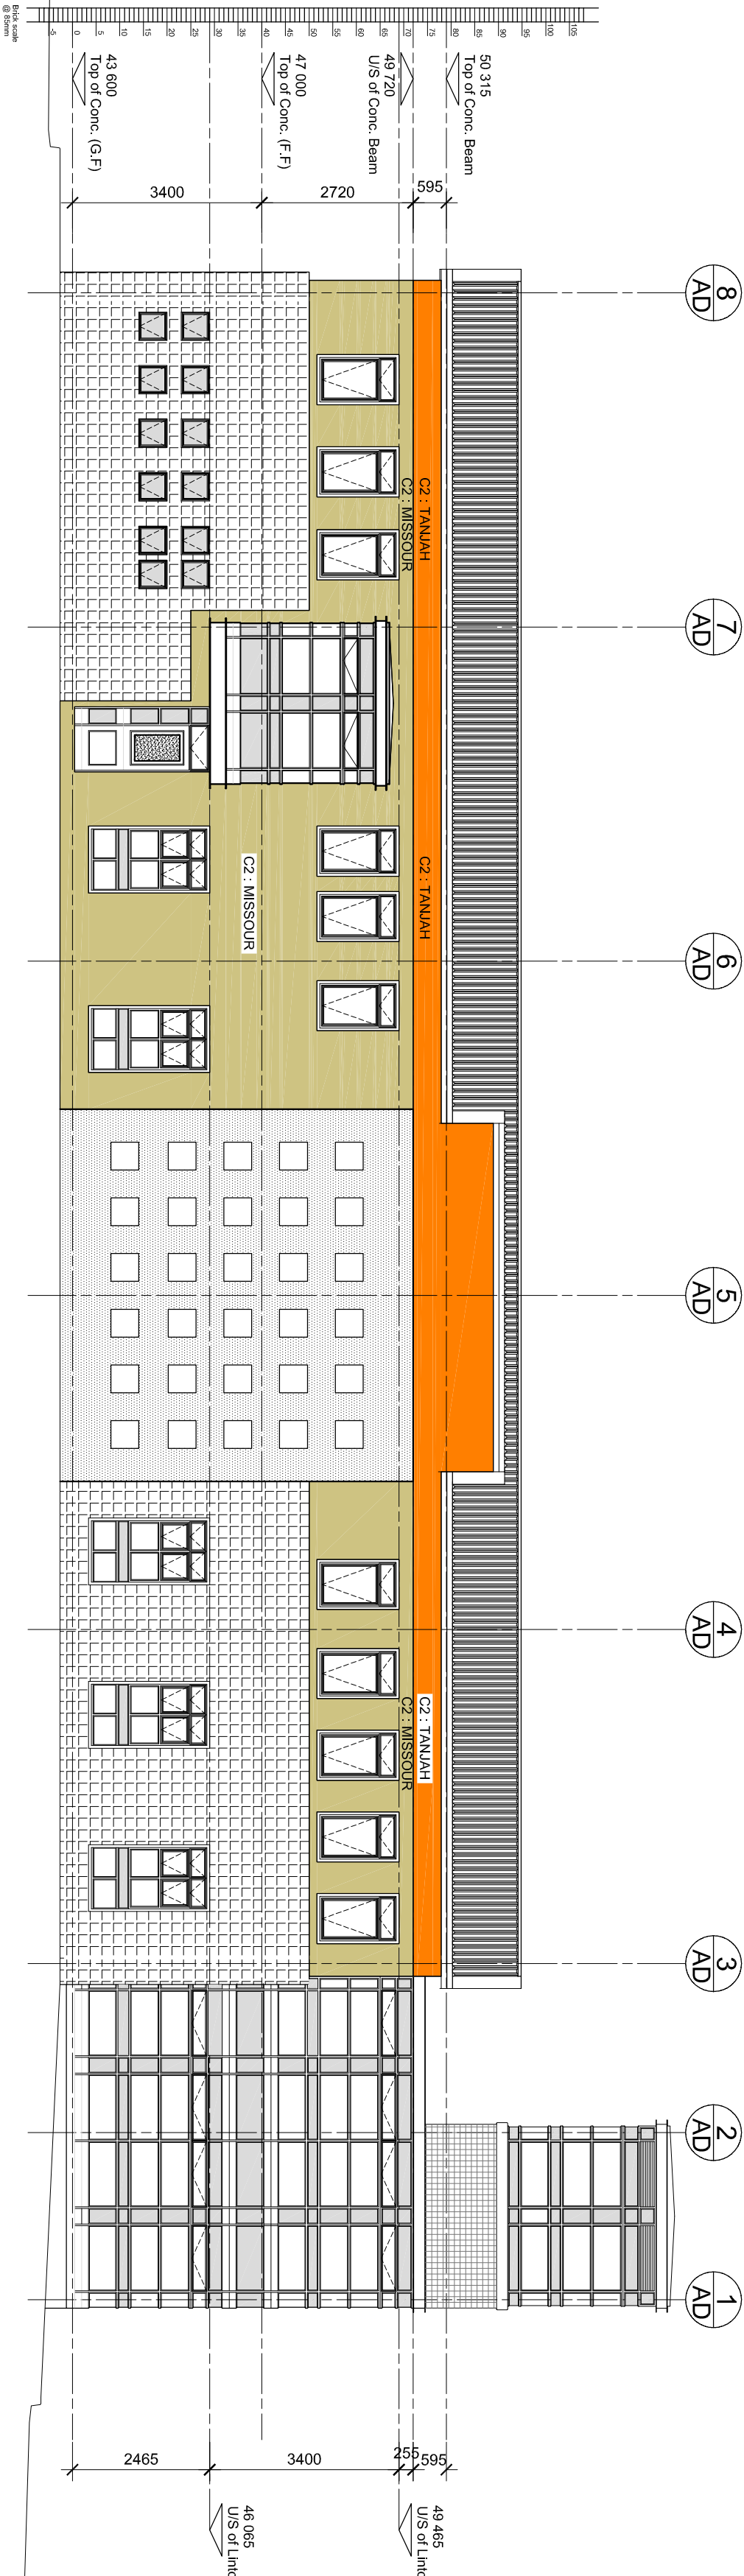
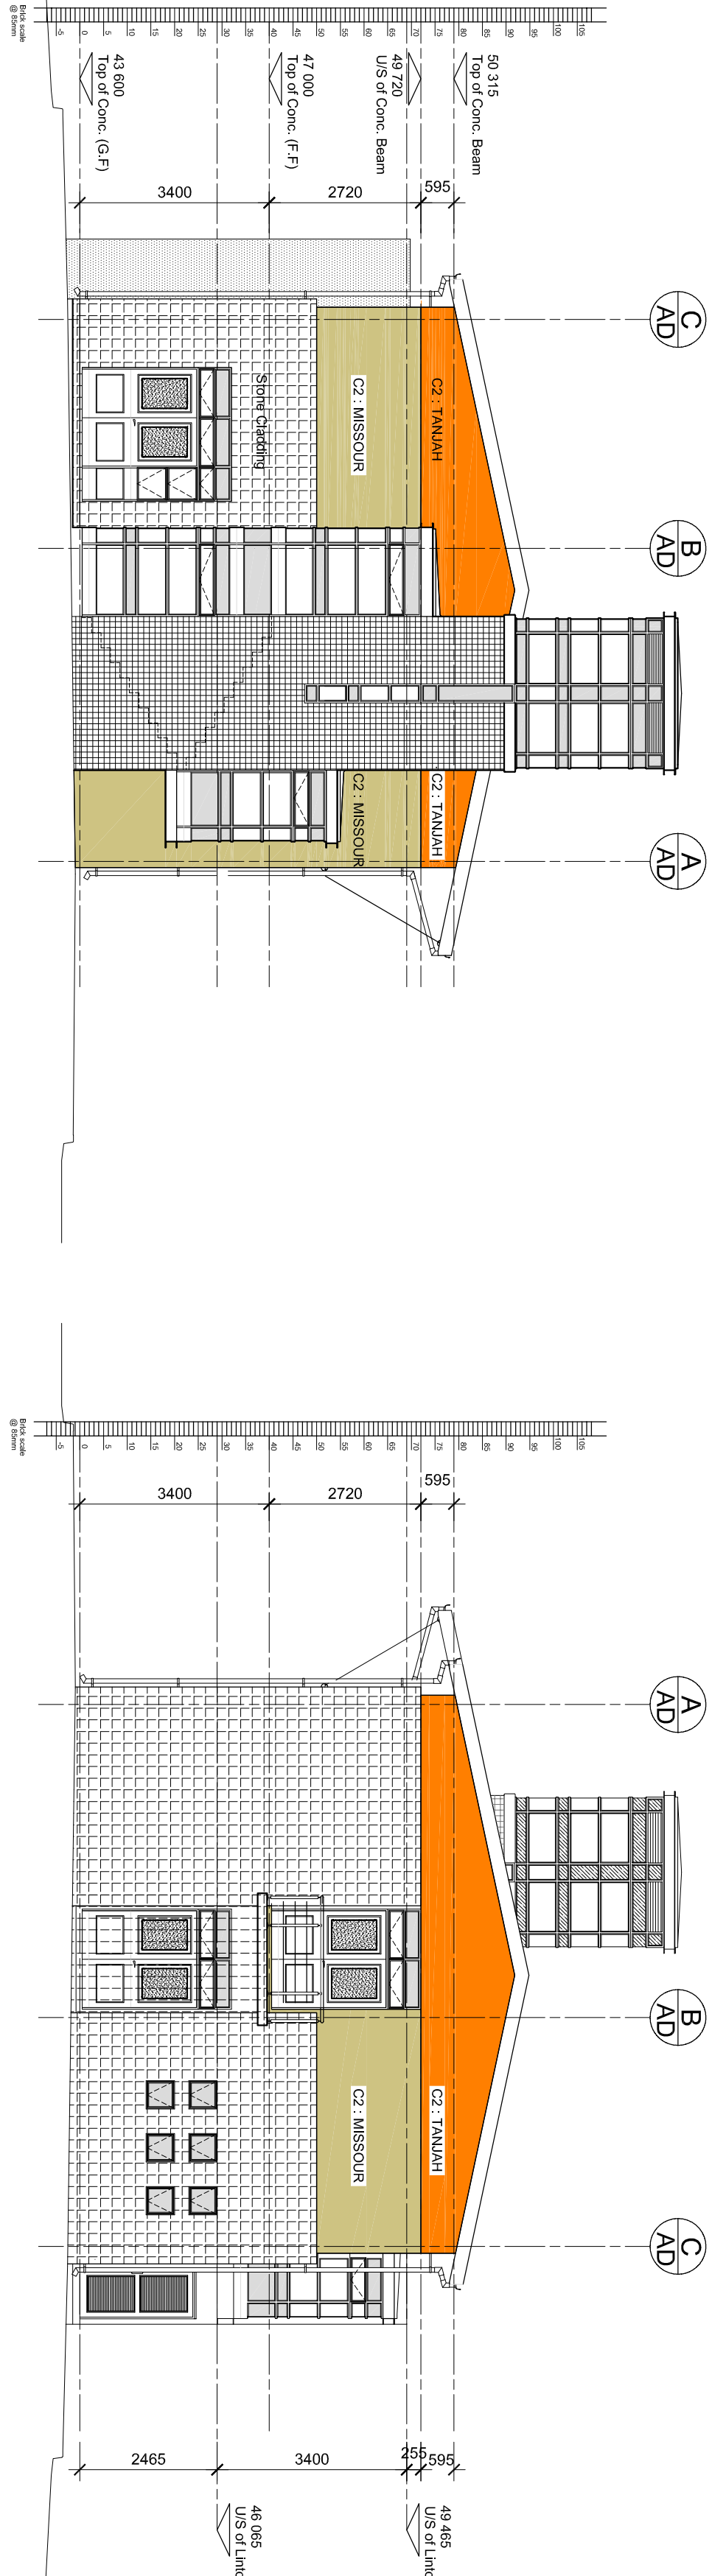
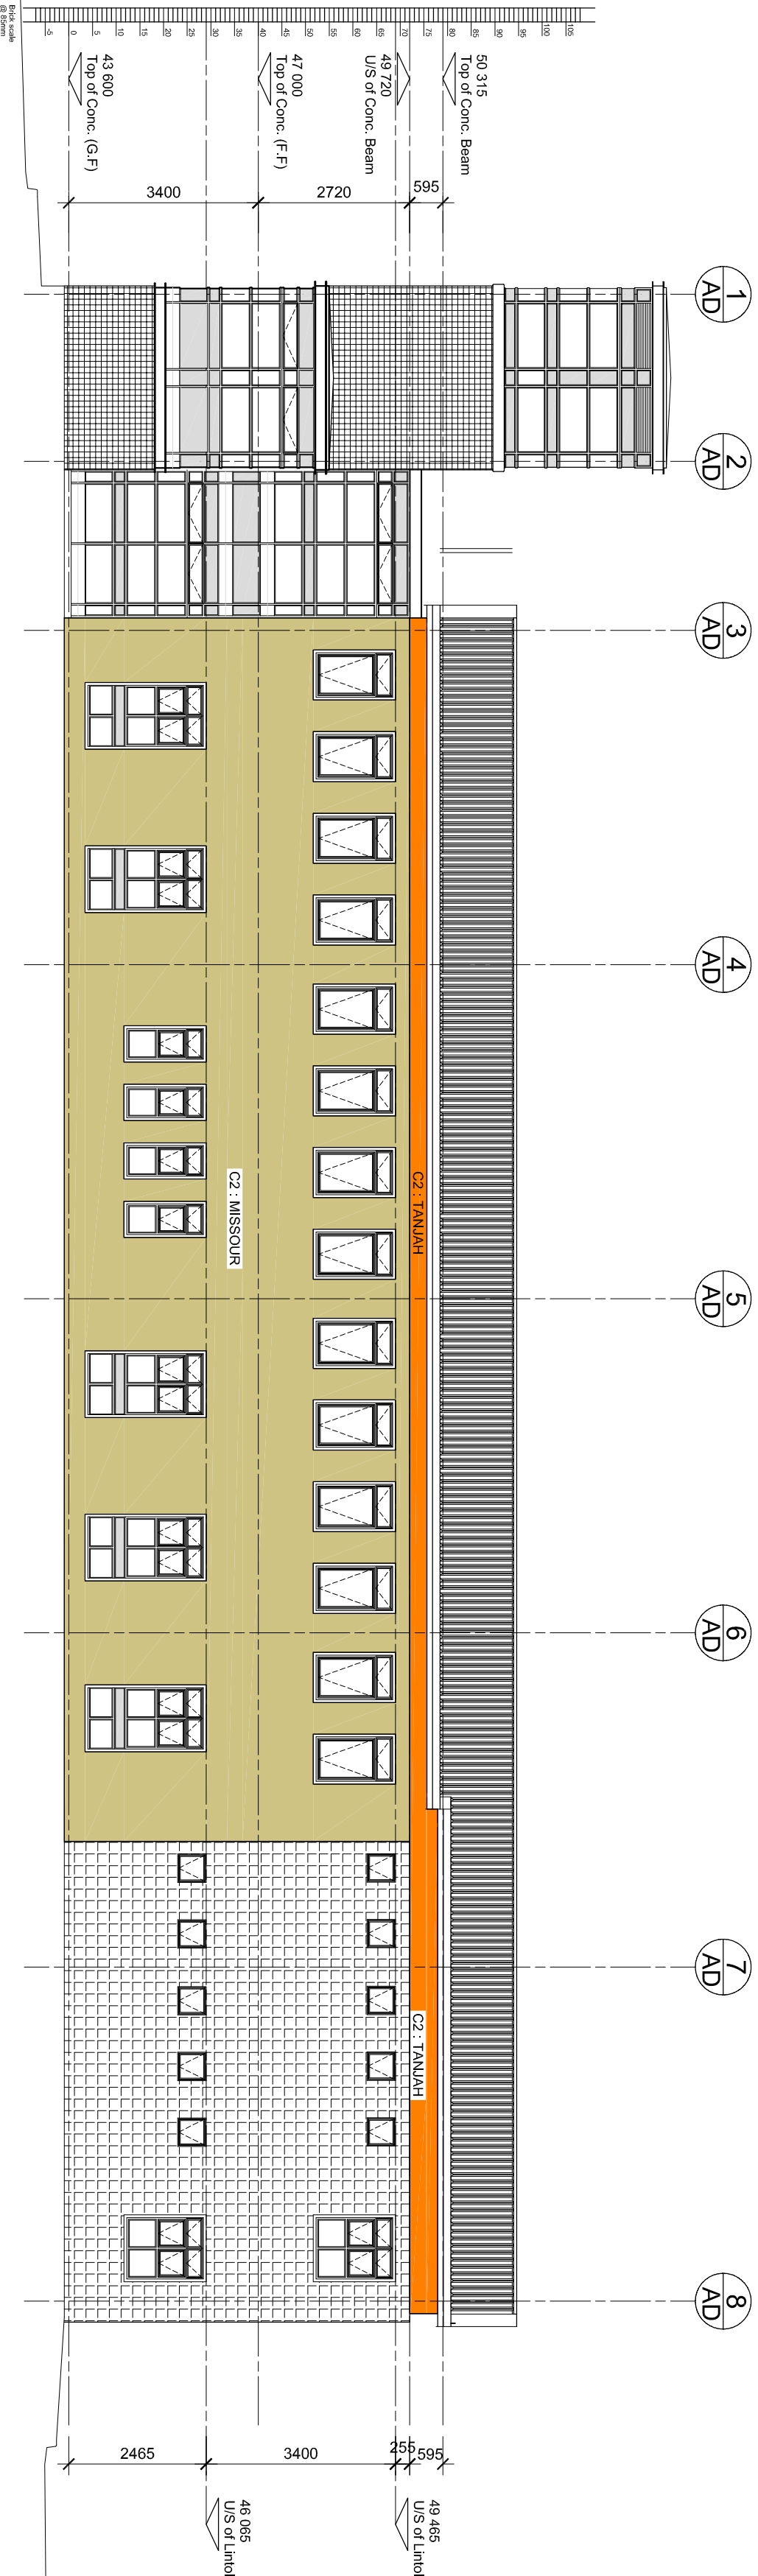
**DESCRIPTION**

**PAINT COLOUR LAYOUT**





**AS BUILT**  
2008 - 01 - 14

**E1004/07A-ADMIN  
PEL01**

2



**ELIDZ: EXTERNAL FINISHES, LEGEND OF PAINT TYPES AND COLOURS**

	External Marmoran on plaster Marmoran Marakseh Finish as per detail specification REF: CZ.
	Colour: Missour.
	External Marmoran on plaster Marmoran Marakseh Finish as per detail specification REF: CZ.
	Colour: Tanjung.

**NOTE:**  
SAMPLE TO BE APPROVED BY ARCHITECT PRIOR TO COMMENCEMENT OF PAINTING.