

## NOTES

ALL DIMENSIONS AND LEVELS ARE TO BE VERIFIED ON SITE PRIOR TO COMMENCING SETTING OUT. WORKSHOP DRAWINGS OR CONSTRUCTION FIGURED DIMENSIONS ONLY TO BE USED. DRAWINGS ARE NOT TO BE SCALED. DISCREPANCIES, ERRORS AND OMISSIONS ARE TO BE BROUGHT TO THE ARCHITECT'S ATTENTION IMMEDIATELY. THEY BECOME VOID ON IMPLEMENTATION. SHOP DRAWINGS TO BE SUBMITTED FOR APPROVAL PRIOR TO ANY RIGHT OF REPRODUCTION OF THIS DRAWING OR ANY PORTION THEREOF. THE REPRODUCTION OF THIS DRAWING OR ANY PORTION THEREOF IS PROHIBITED.

REV.	DATE	DESCRIPTION
A	08/11/2004	-
B	14/07/2008	AS BUILT

[illegible]

Client  
**EAST LONDON IDZ (PTY) LTD**

**P. NGCUKA**

**JOINT VENTURE**

**OSMOND LANGE ARCHITECTS & PLANNERS JOINT VENTURE**

151 FLOOR #107 MILL MOORE TOWER  
CHERRY LANE EAST LONDON  
E20 2J1 0090 E: [elizabeth@oslan.co.uk](mailto:elizabeth@oslan.co.uk)

**EAST LONDON INDUSTRIAL  
DEVELOPMENT ZONE  
ZONE 1D**

<p><b>Title</b></p> <p><b>ZONE 1D ENTRANCE CANOPY SECTIONS AND ELEVATIONS</b></p>			
<p><b>Scale</b></p> <p>1:100</p>	<p><b>Date</b></p> <p>08/11/2004</p>	<p><b>Drawn</b></p> <p>Zuks</p>	<p><b>Checked</b></p> <p>A.V.P.</p>


### DESCRIPTION

DRAWING NO	REVISION

**AS BUILT**  
2007 - 12 - 11


2007 - 12 - 11

**B**

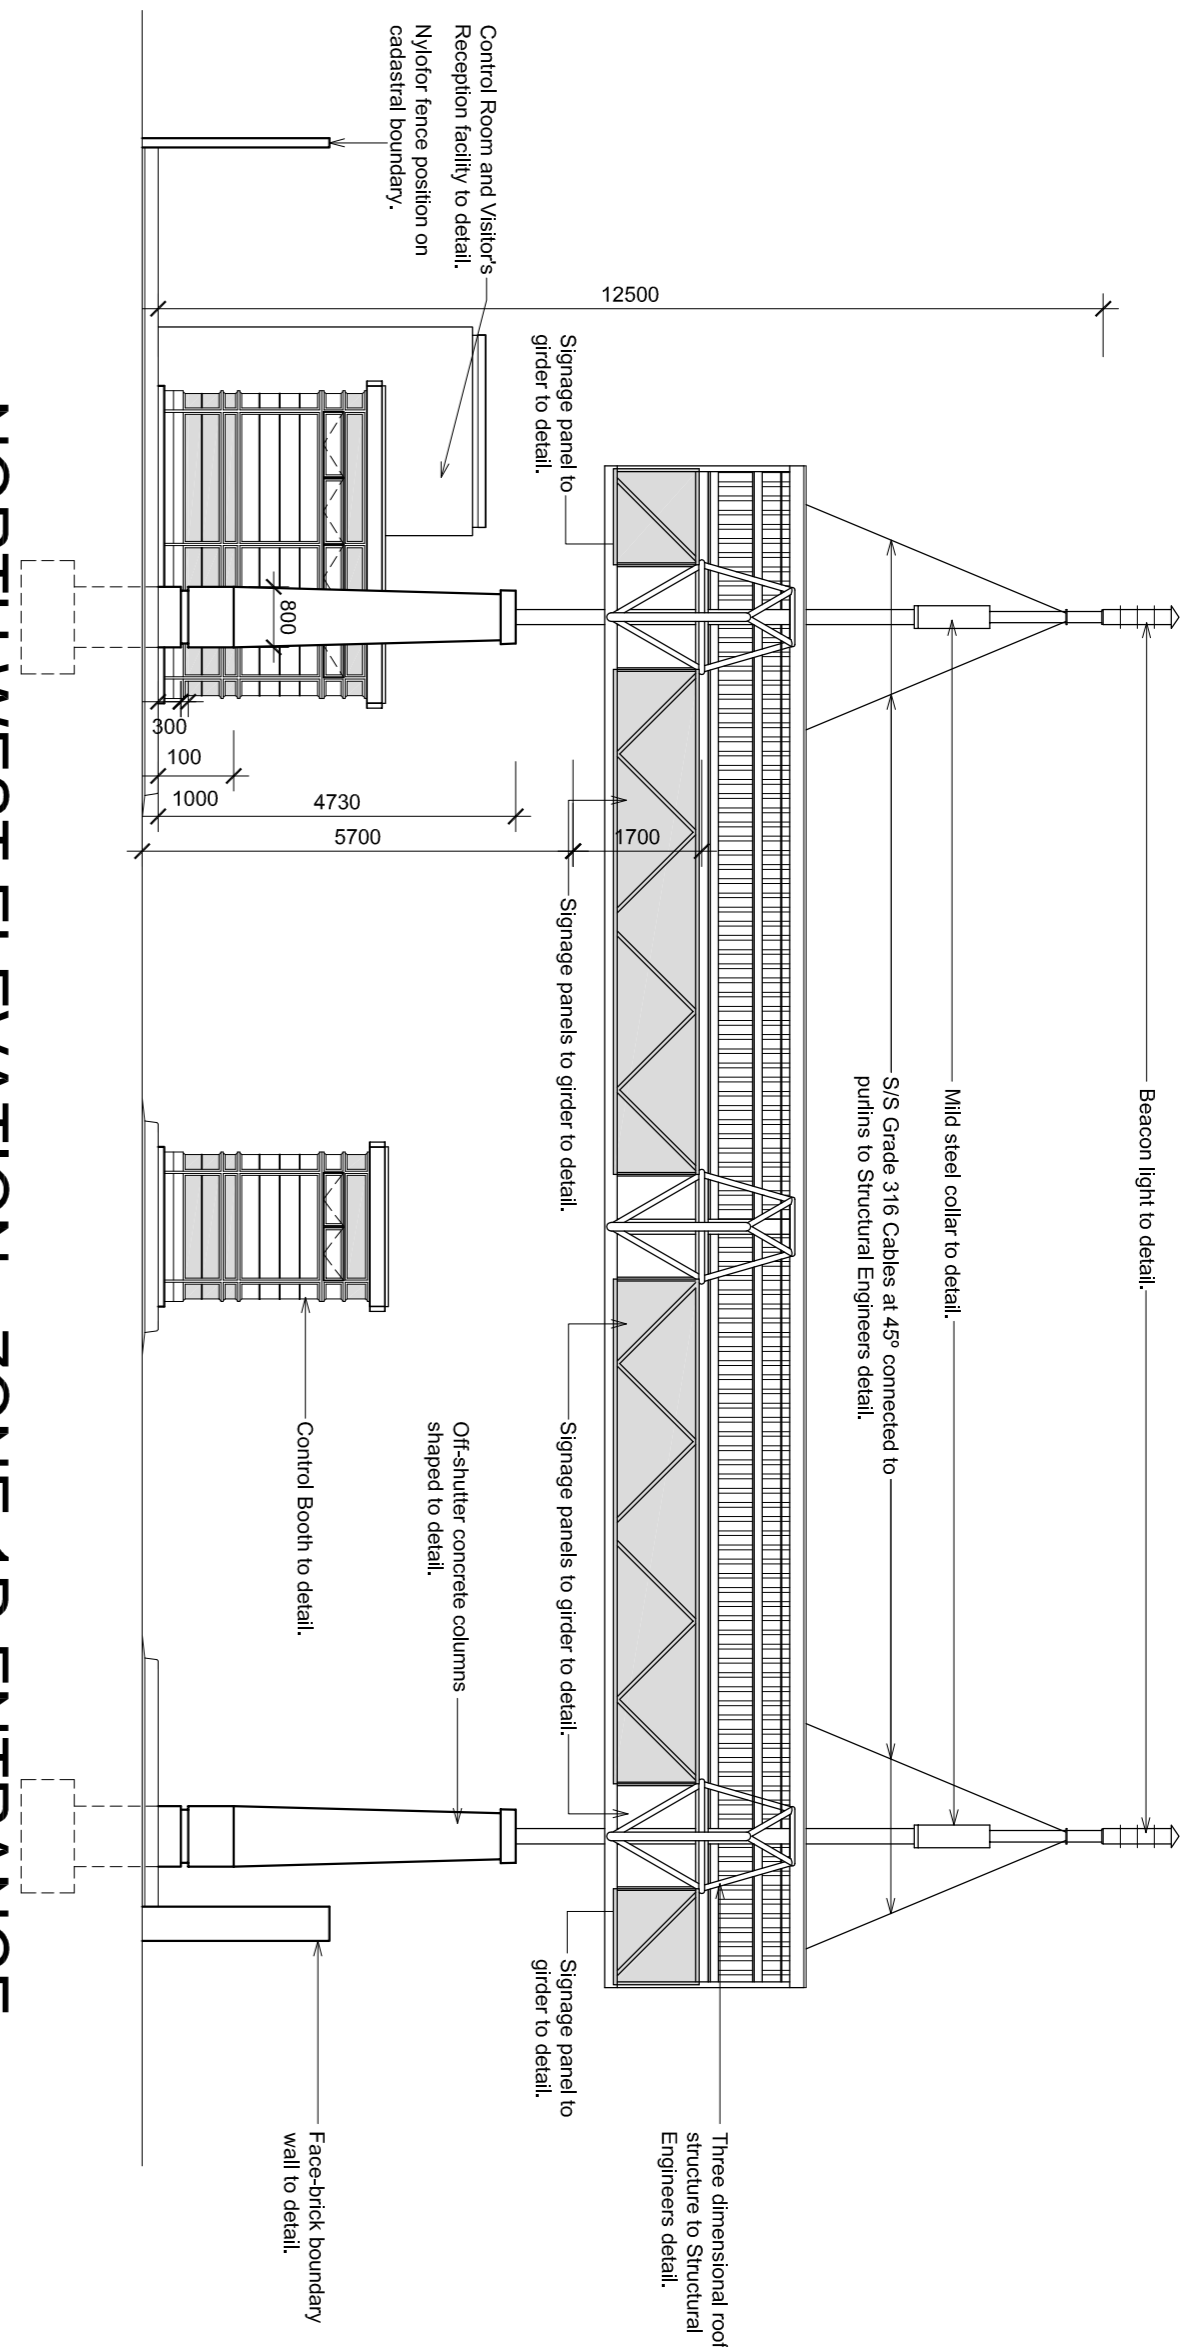


# NORTH WEST ELEVATION - ZONE 1D ENTRANCE

Scale 1:100

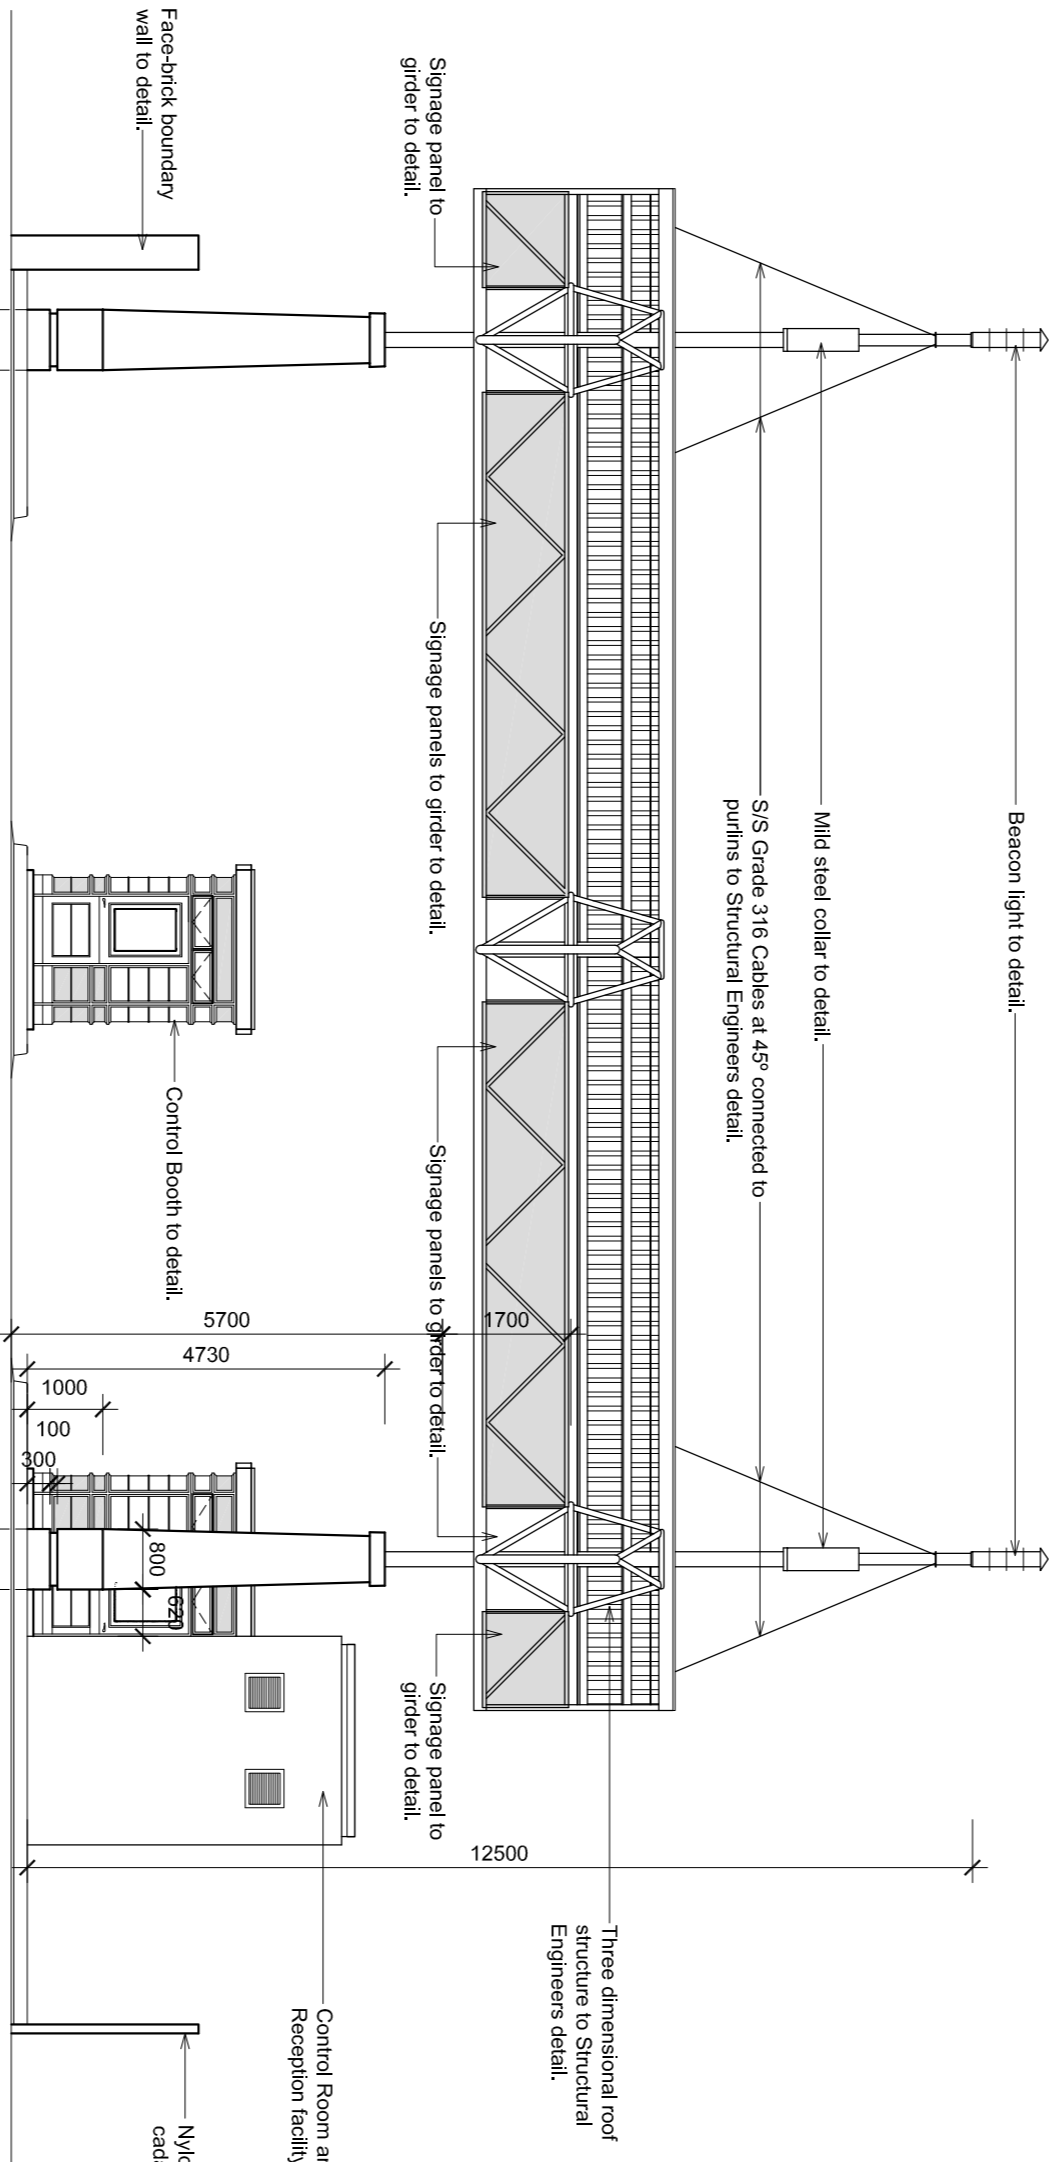


SOUTH EAST ELEVATION - ZONE 1D ENTRANCE

Scale 1:100

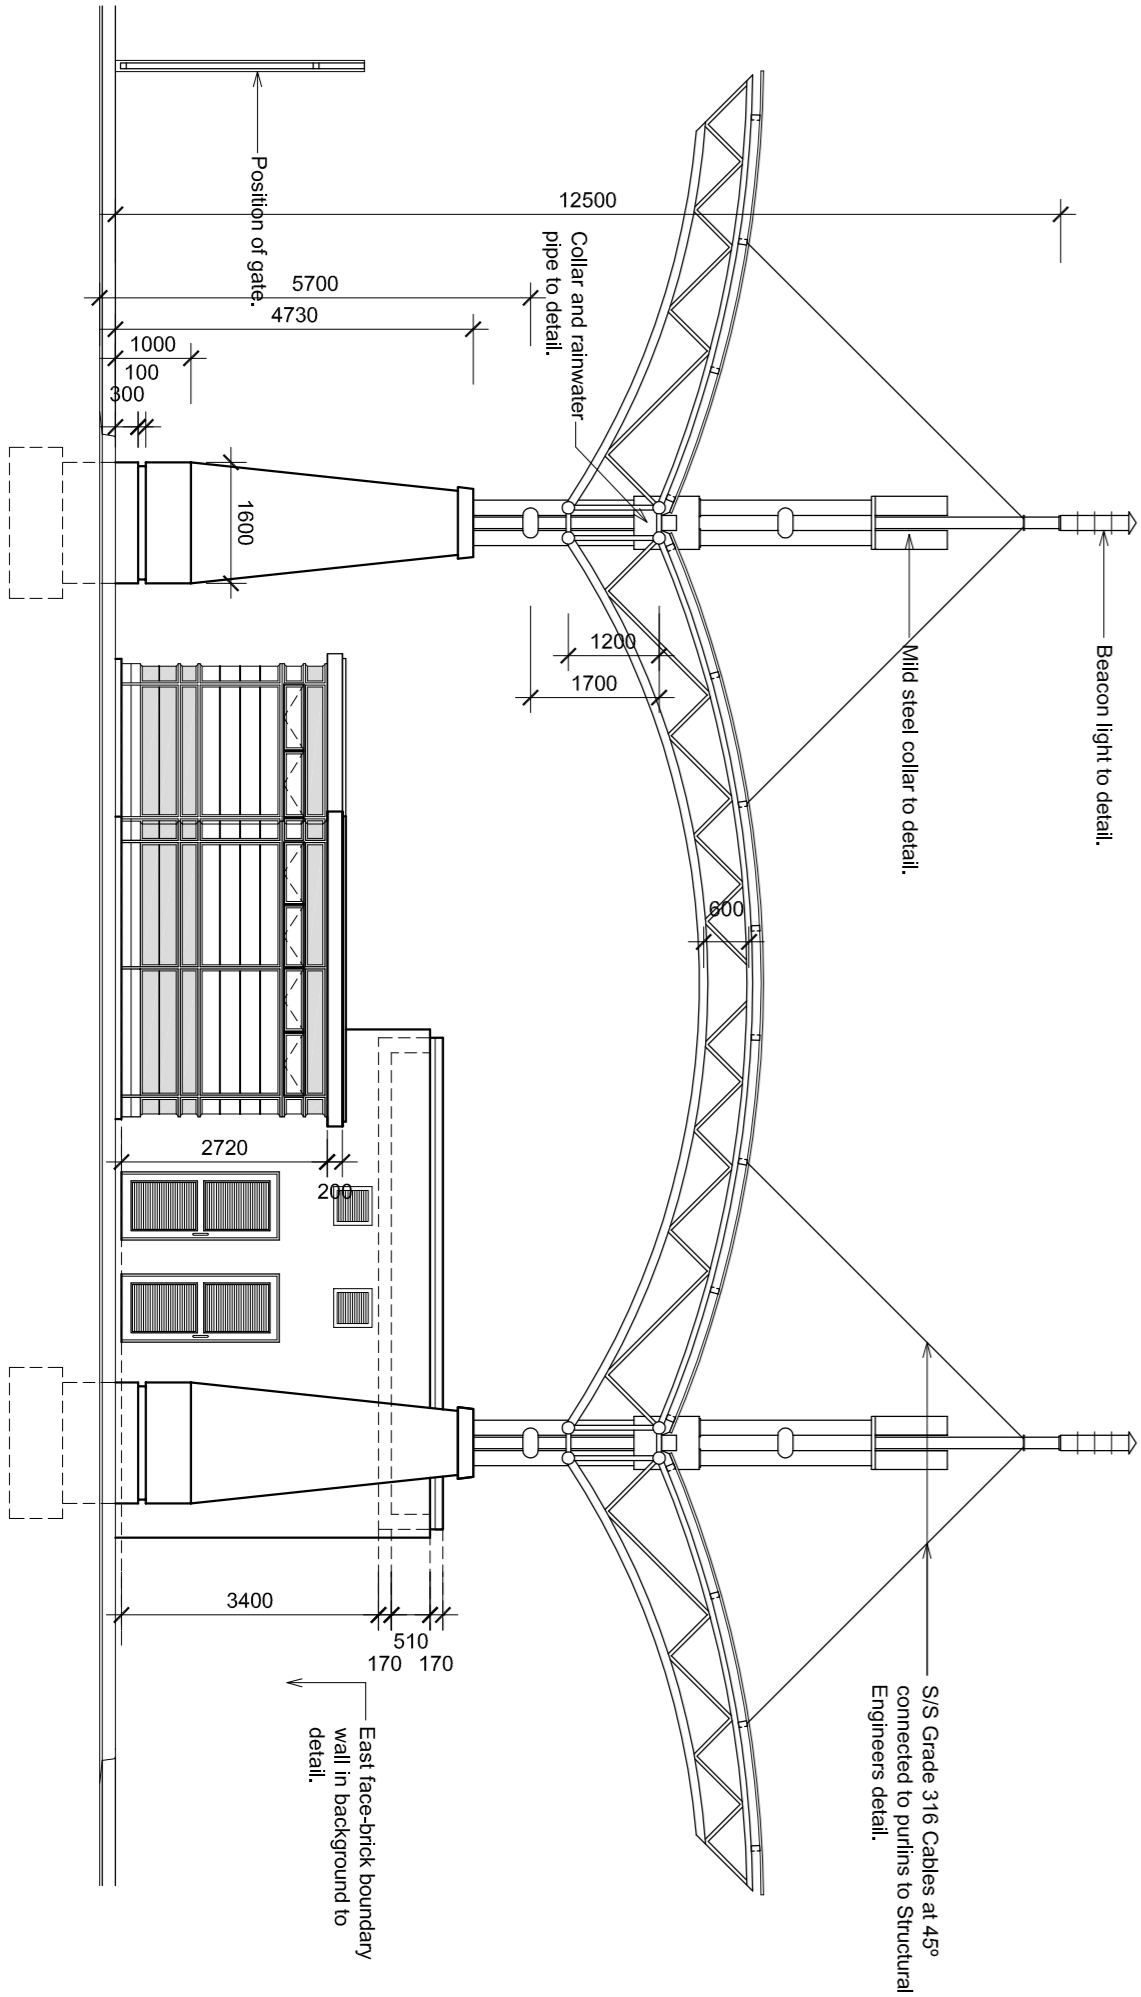


SOUTH WEST ELEVATION - ZONE 1D ENTRANCE

Scale 1:100

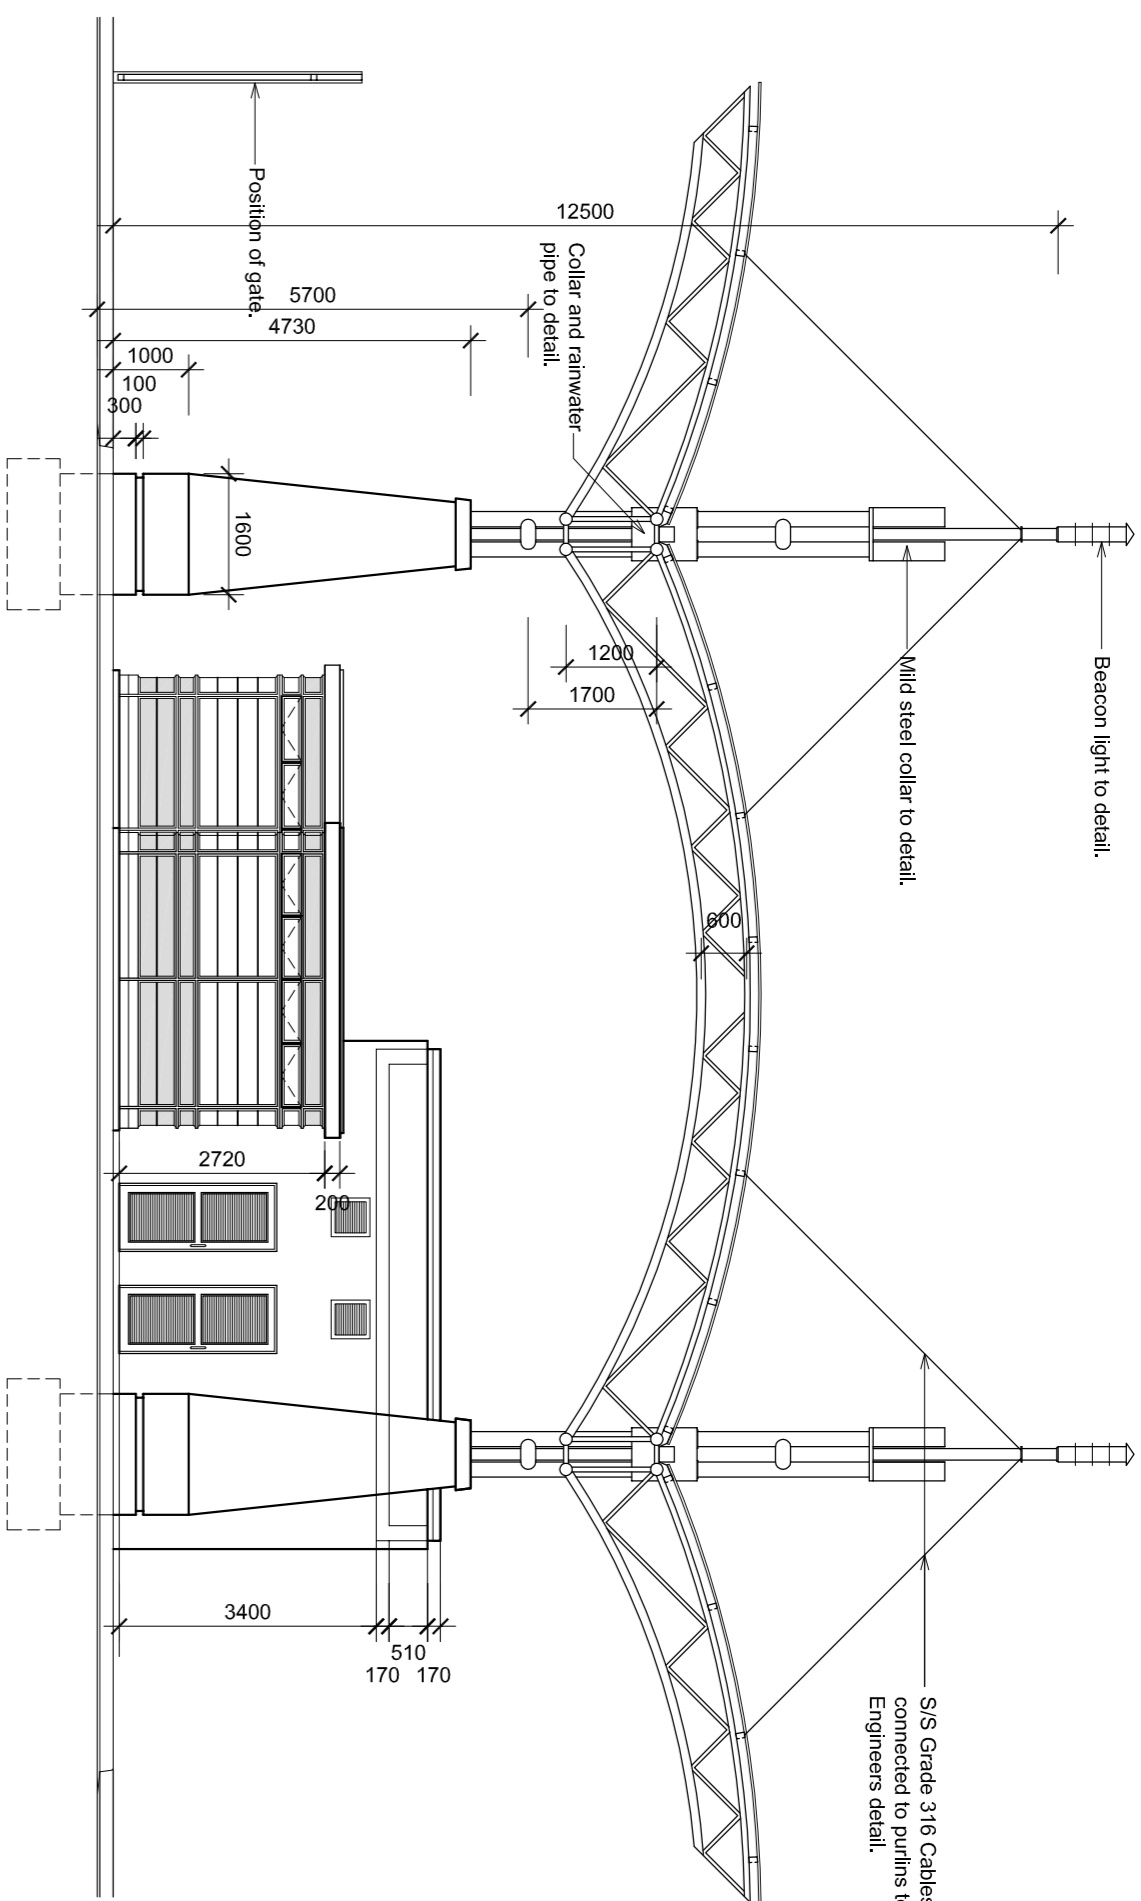


SOUTH WEST SECTIONAL ELEVATION - ZONE 1D ENTRANCE

Scale 1:100

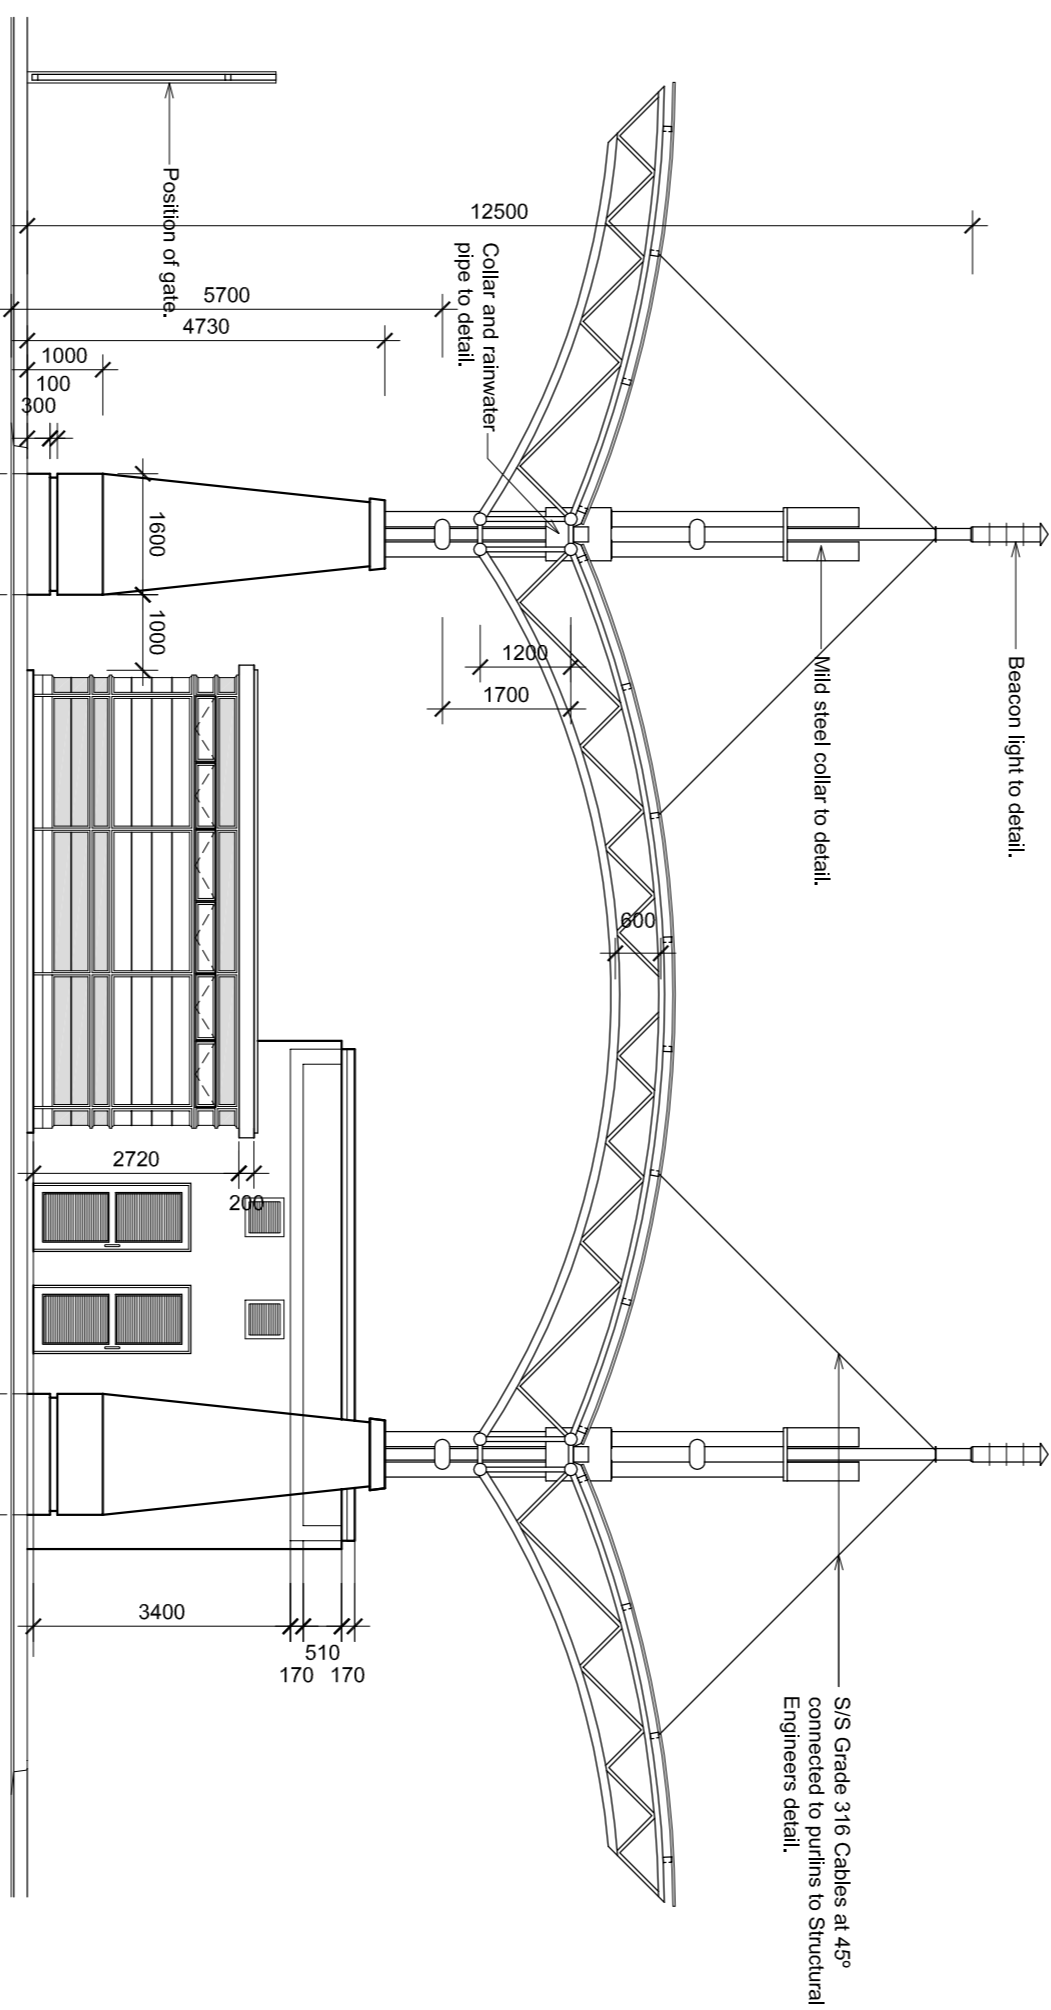

SOUTH WEST SECTIONAL ELEVATION - ZONE 1D ENTRANCE

Scale 1:100

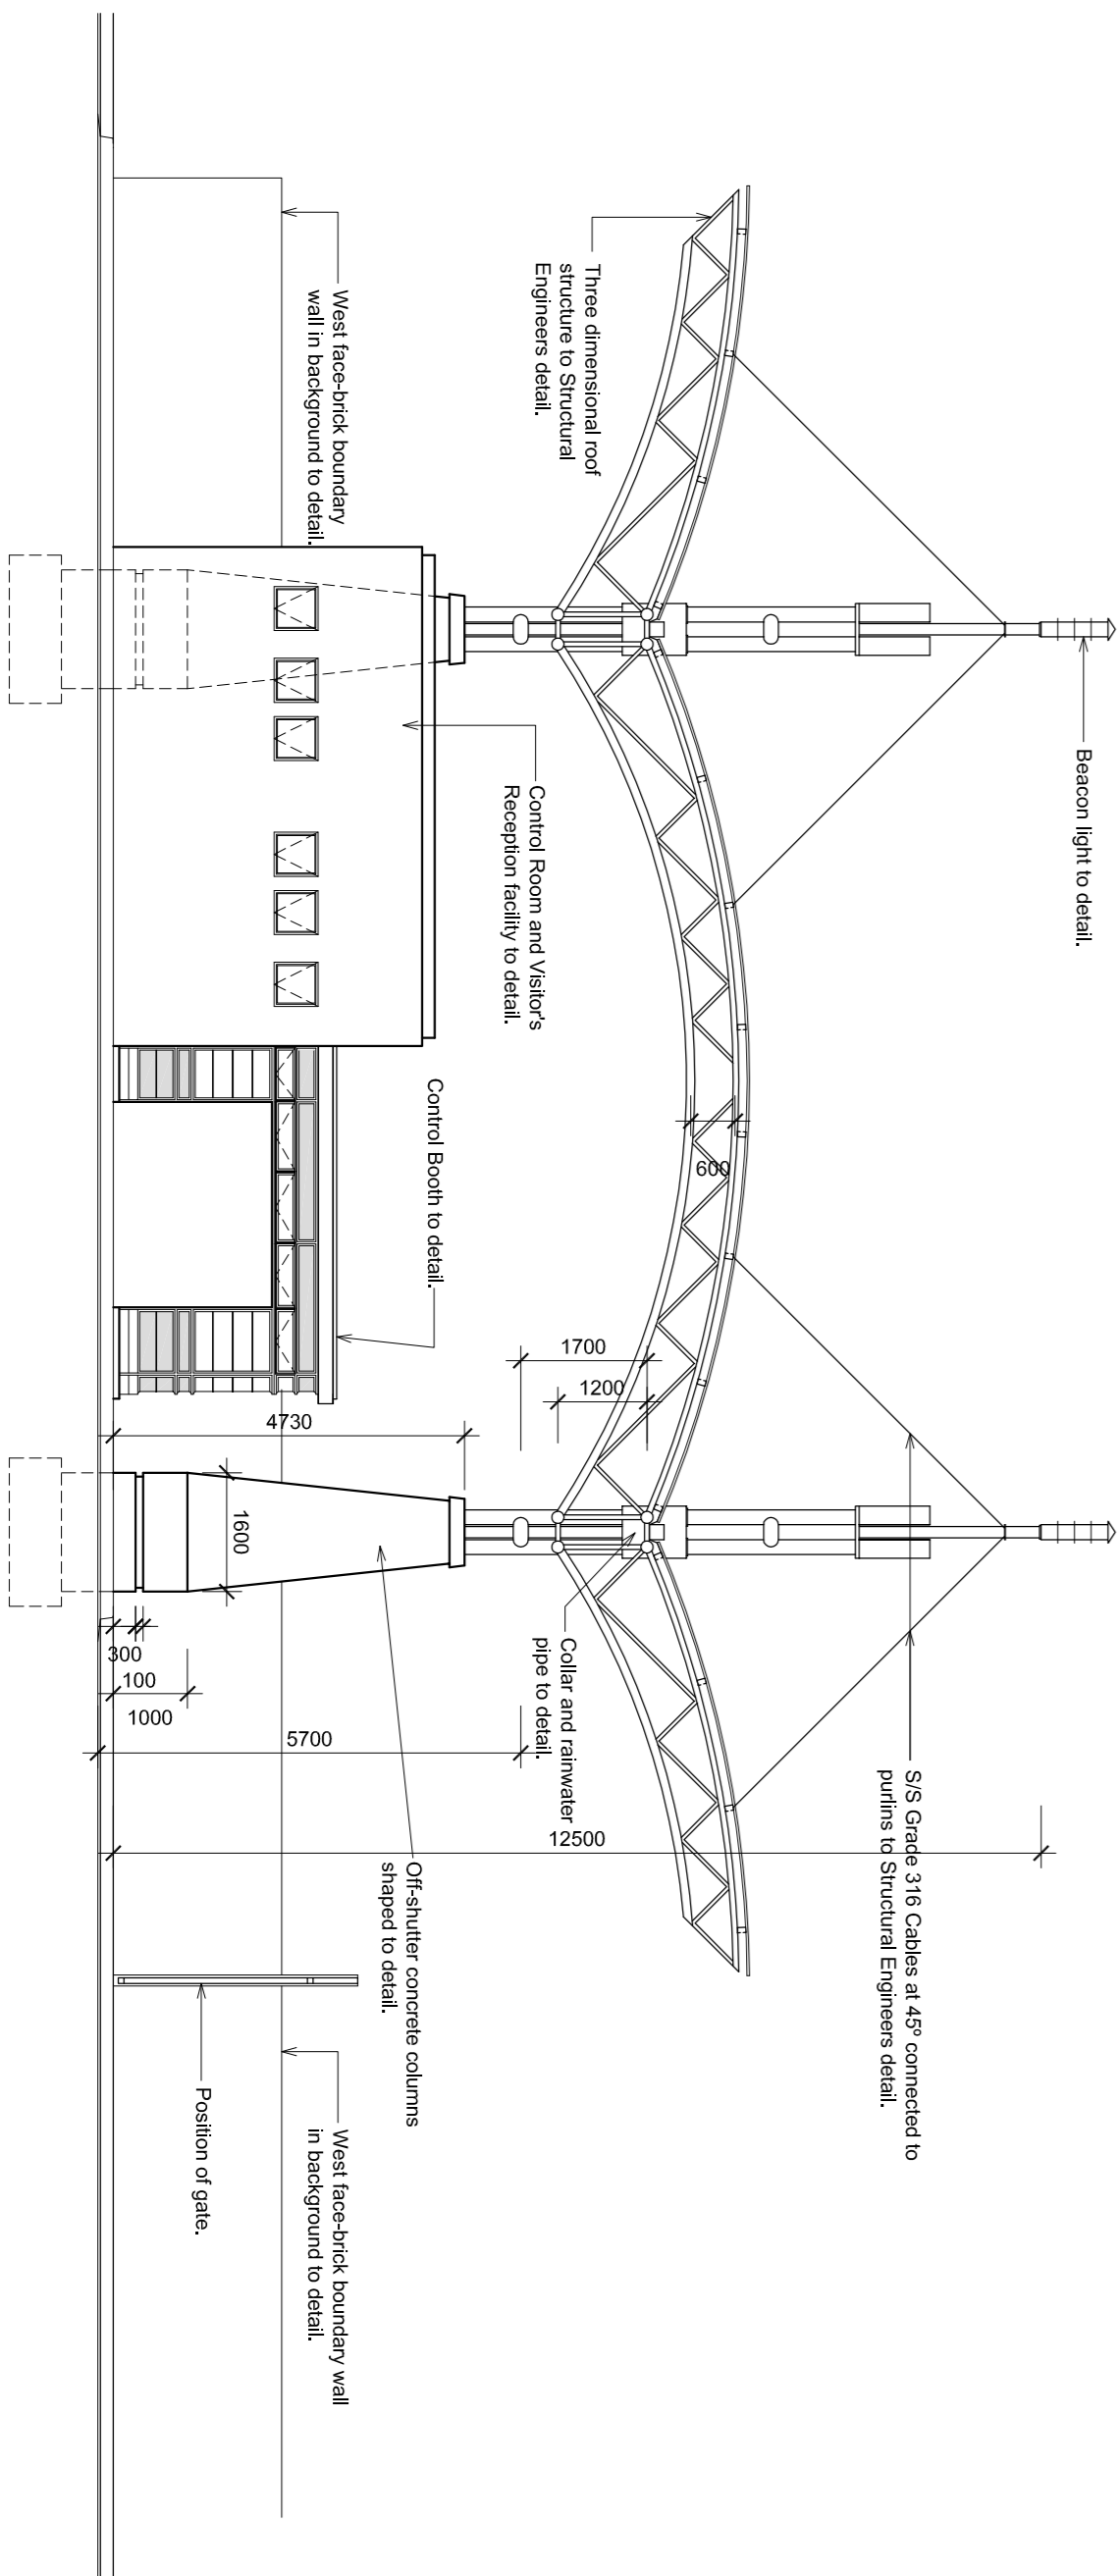

NORTH EAST ELEVATION - ZONE 1D ENTRANCE

Scale 1:100

**AS BUILT**  
2007 - 12 - 11

**B**

**B**