



NOTES:
1. ALL PANELS TO BE FULLY Banded GALVANISED MILD STEEL RS40 - 25x4.5mm - 30kg.
2. LAYOUT SHOWS DIRECTION OF SPAN FOR EACH PANEL. ACTUAL PANEL SIZES TO BE CHECKED AND CONFIRMED ON SITE.
3. HOT DIP GALVANISING TO BE CARRIED OUT ON INDIVIDUAL PANELS AFTER ALL CUTTING AND WELDING HAS BEEN COMPLETED.

KEY PLAN RECTAGRID (GROUND FLOOR)

SCALE 1:50

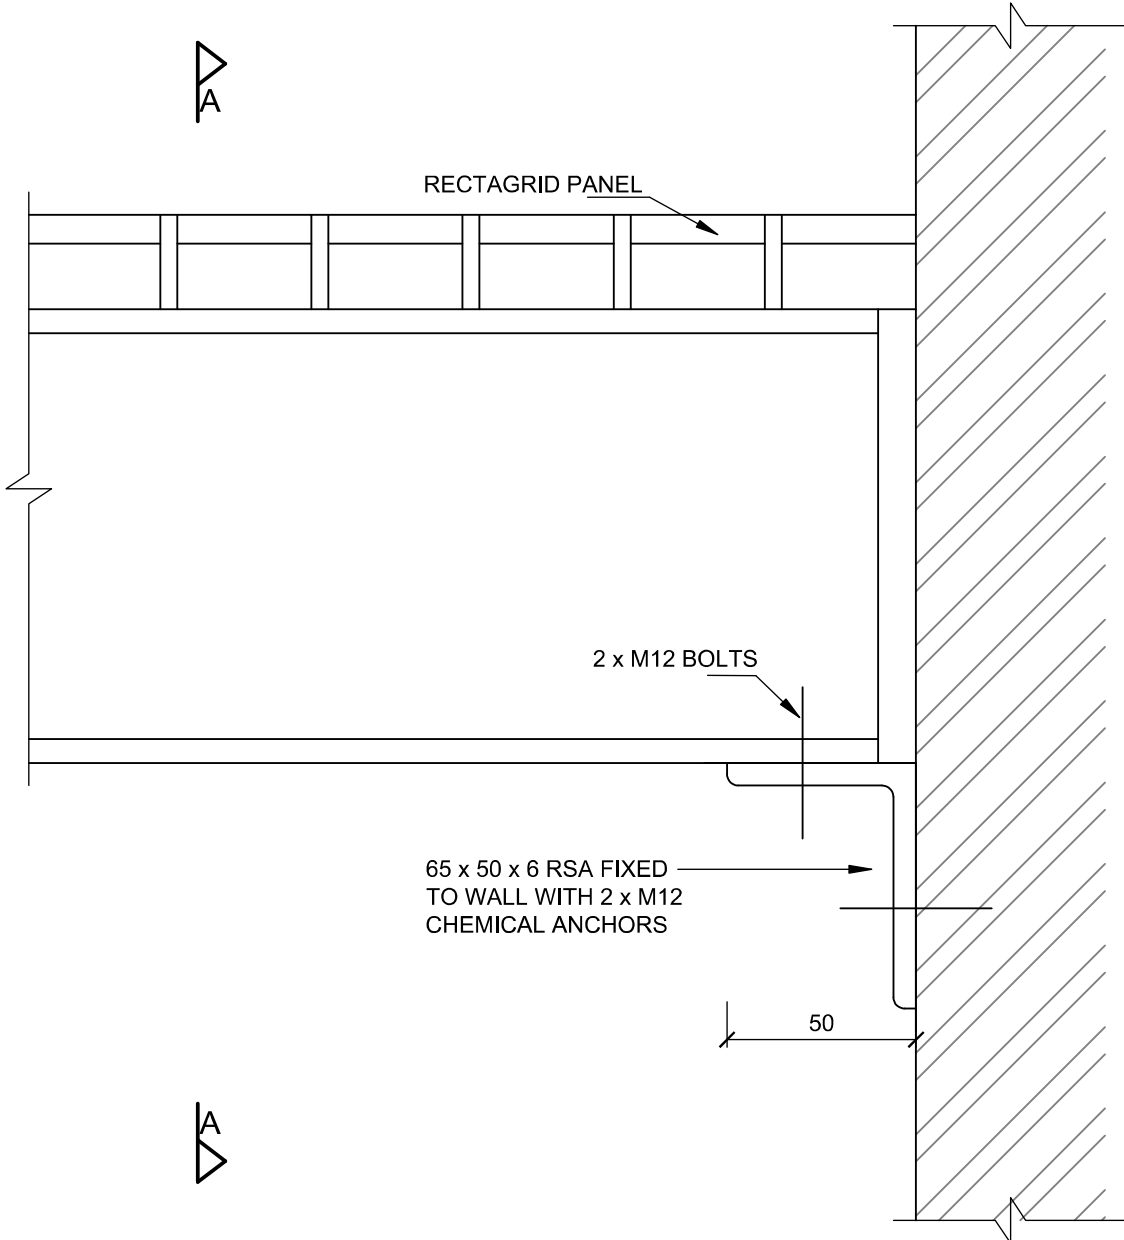


ELEVATION

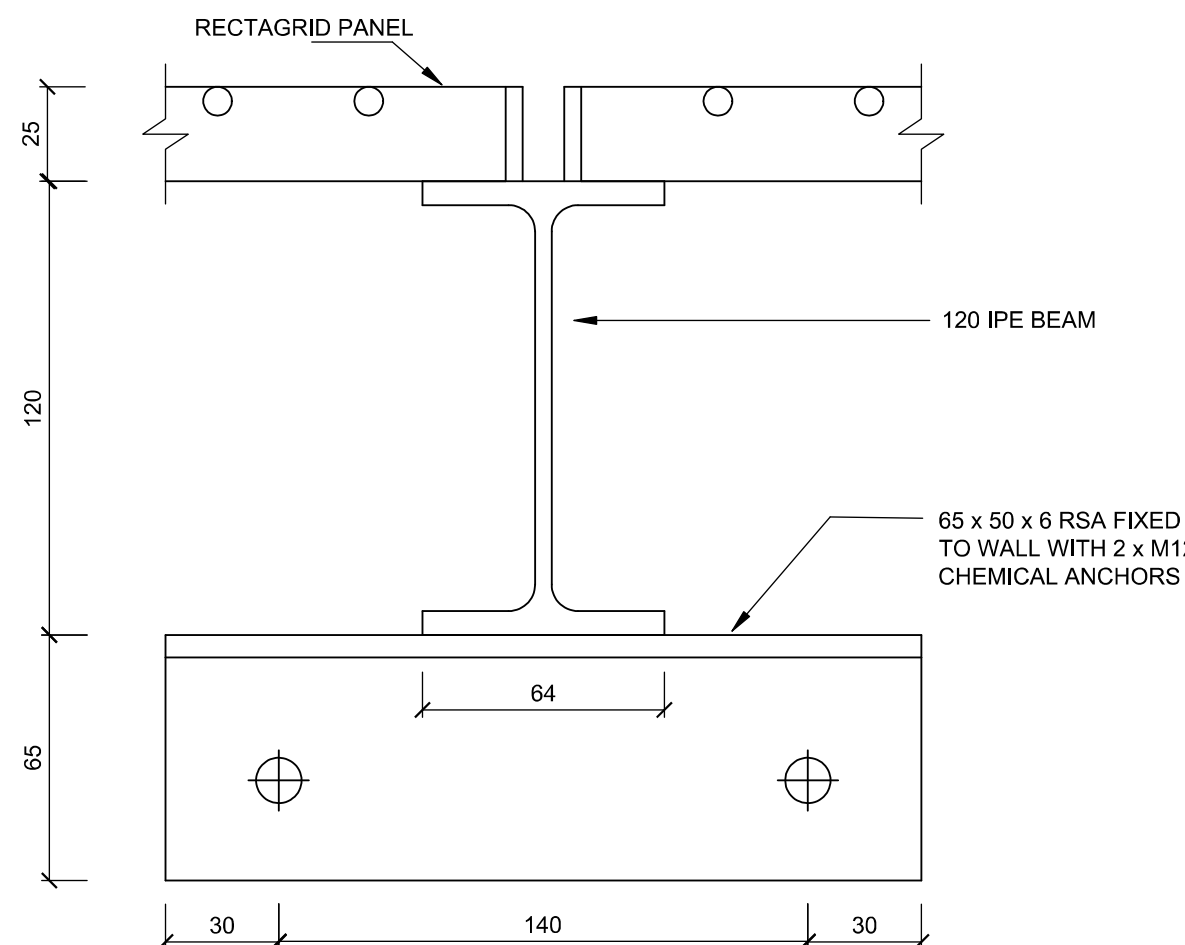

SECTION A-A

DETAIL OF FIXING FOR IPE SUPPORTS

SCALE 1:2

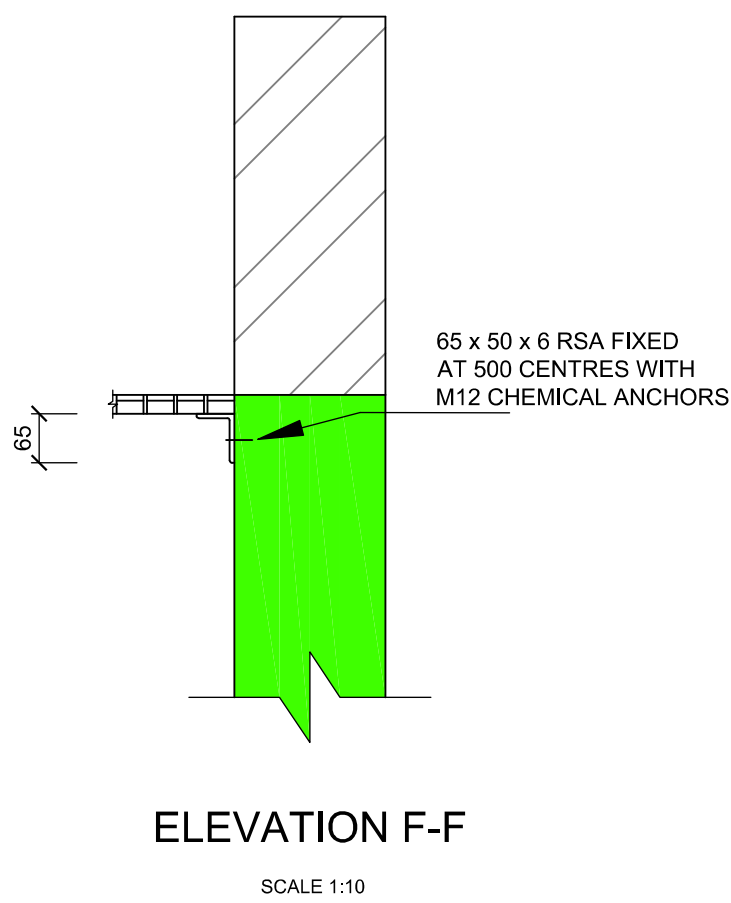


ELEVATION F-F

SCALE 1:10

DETAIL OF FIXING FOR ANGLE IRON FRAMES


SCALE 1:10

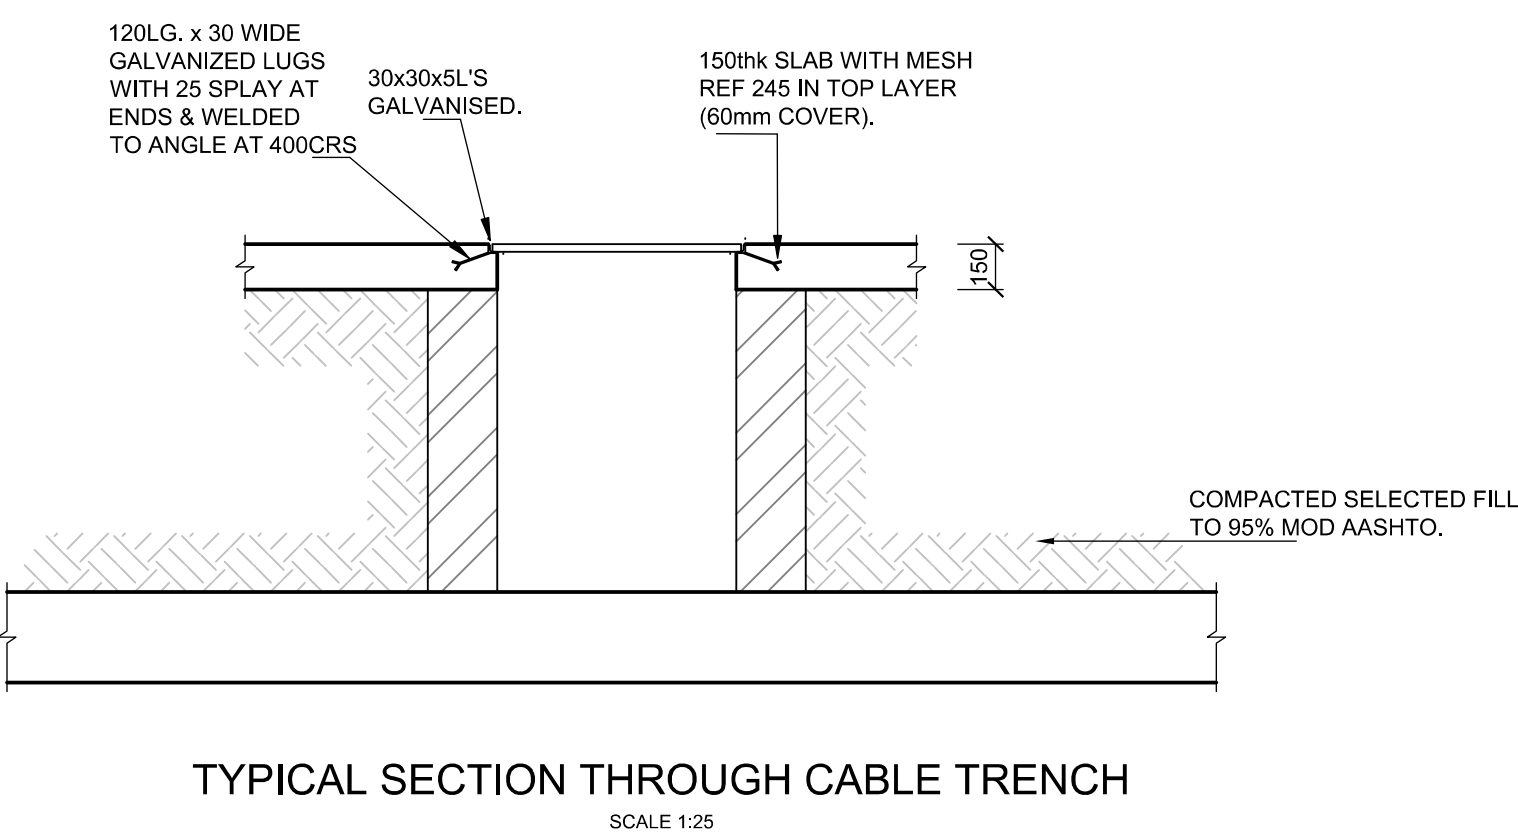

TYPICAL SECTION THROUGH CABLE TRENCH


SCALE 1:25

RECTAGRIDS OVER DUCTS IN ELECTRICAL ROOMS

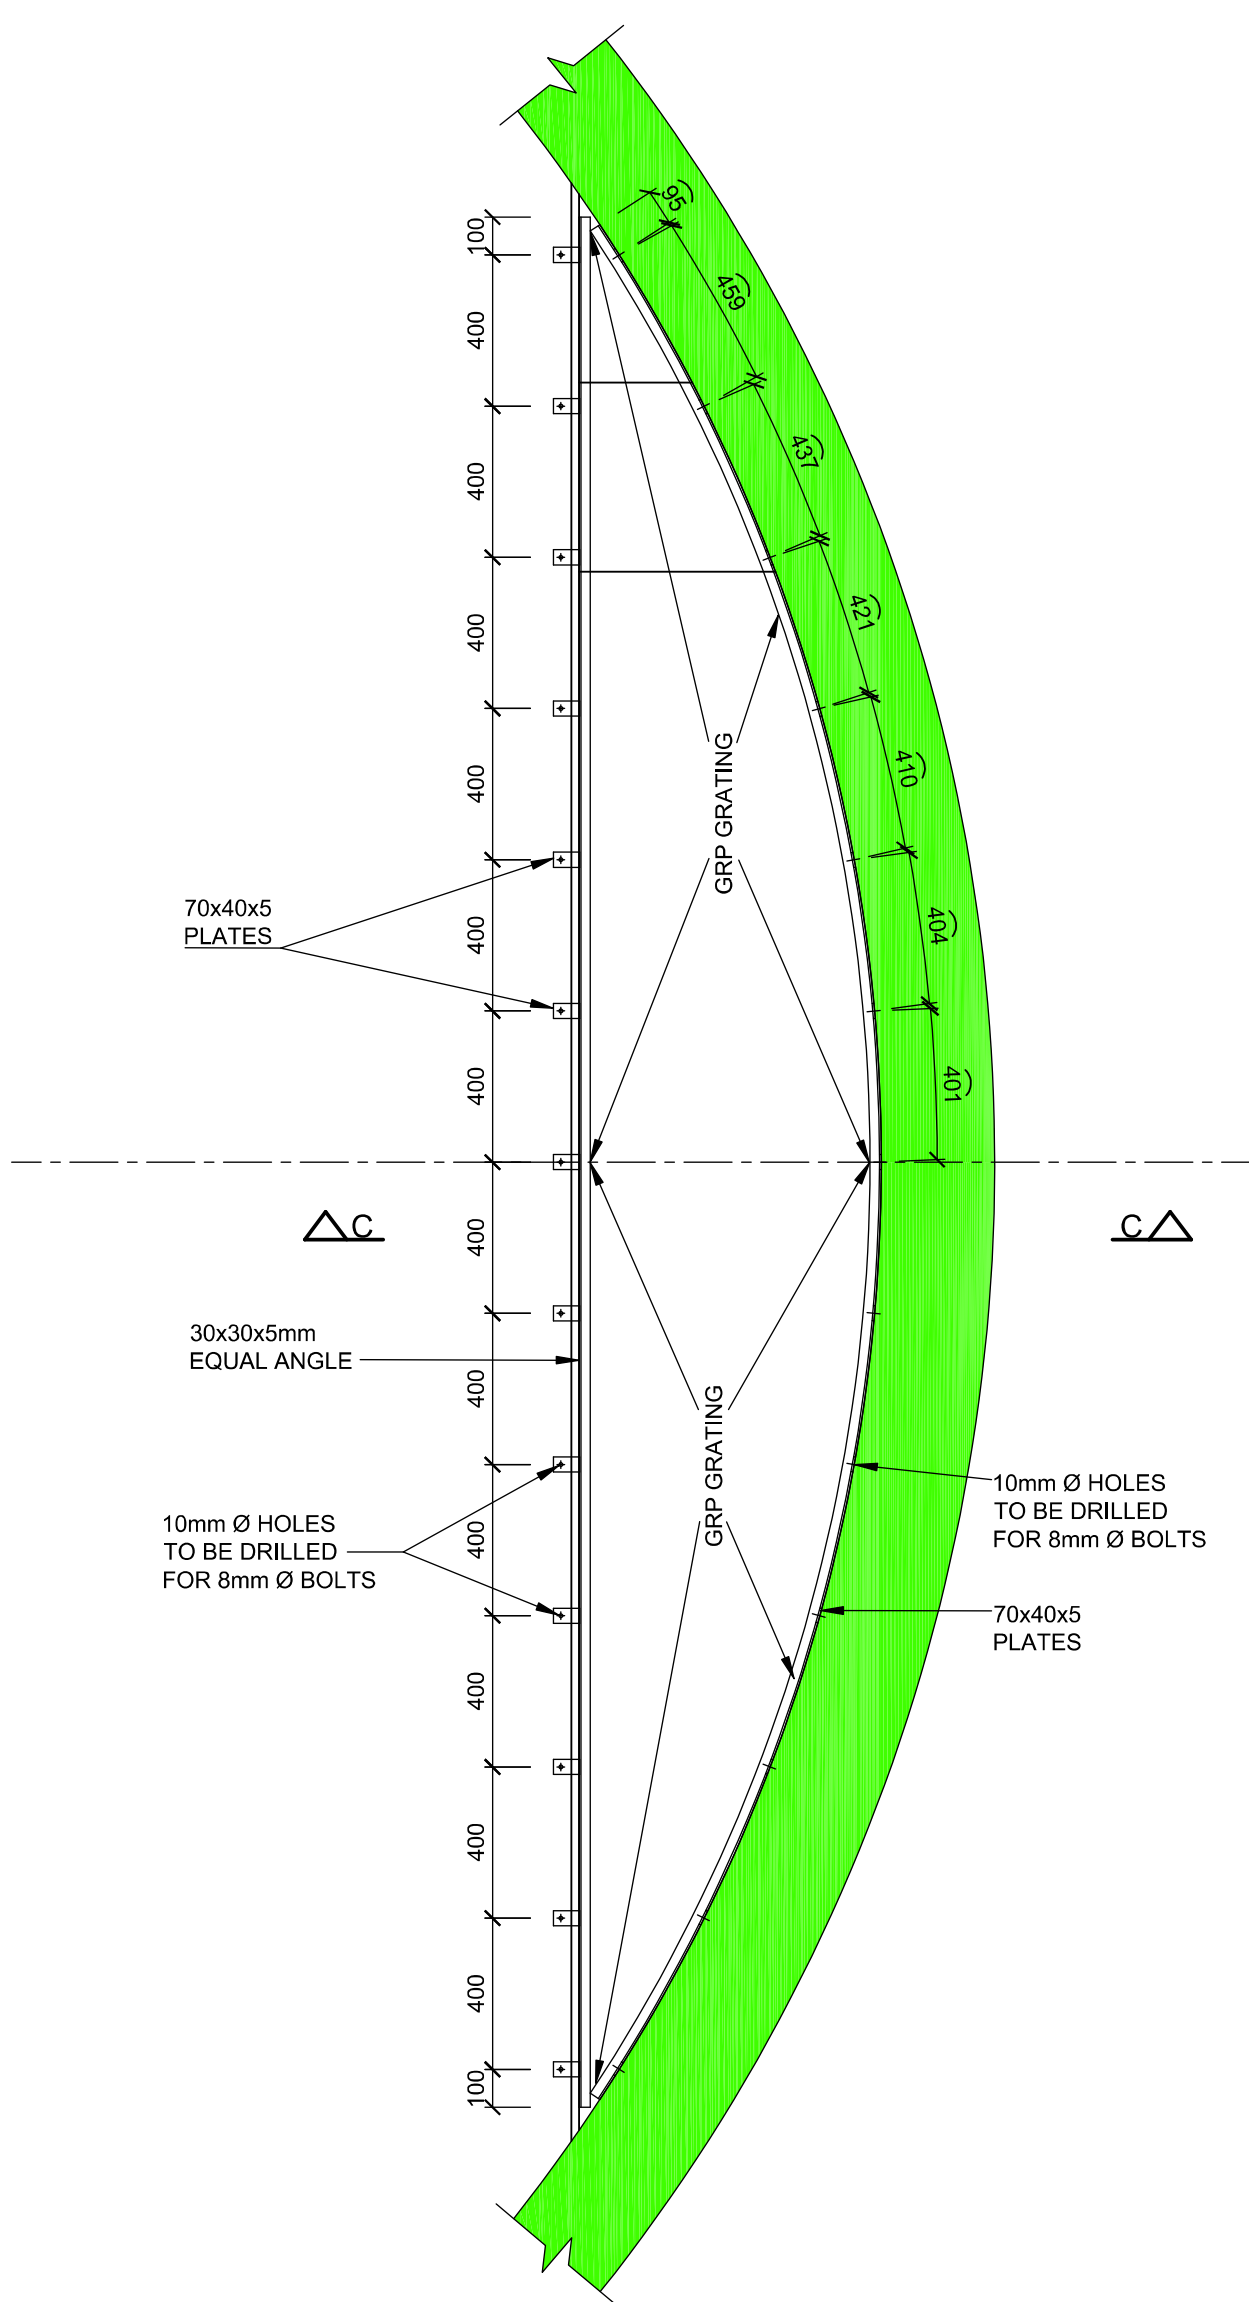

LAYOUT


SCALE 1:20

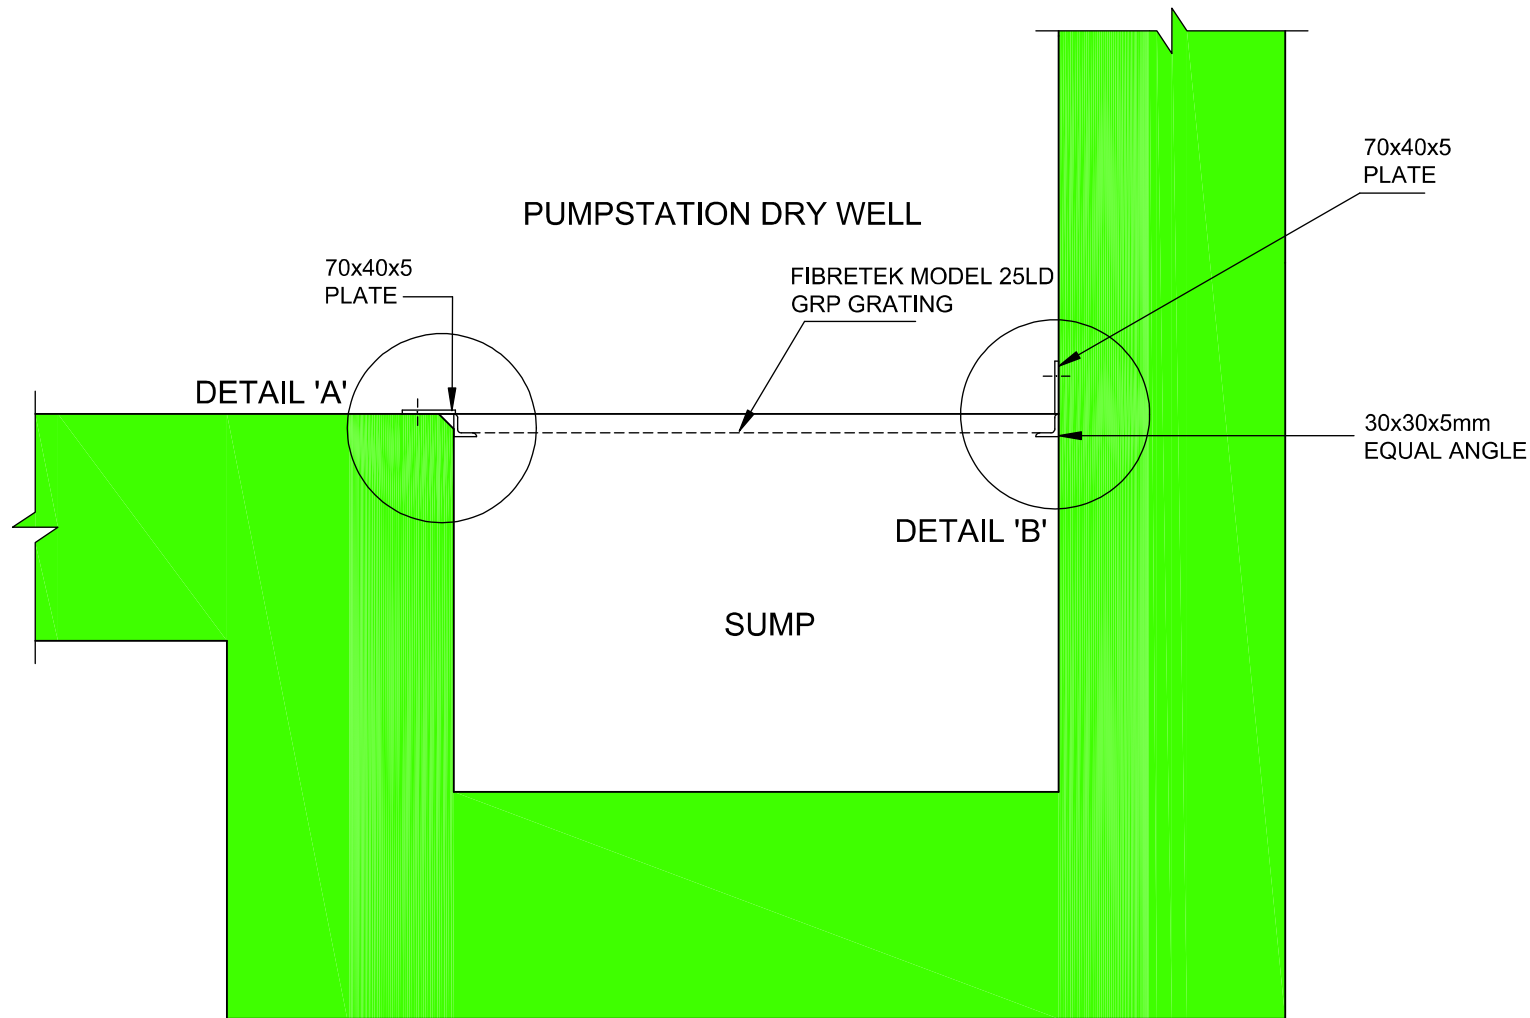

SECTION C-C


SCALE 1:10

RECTAGRID DETAILS FOR DRY WELL

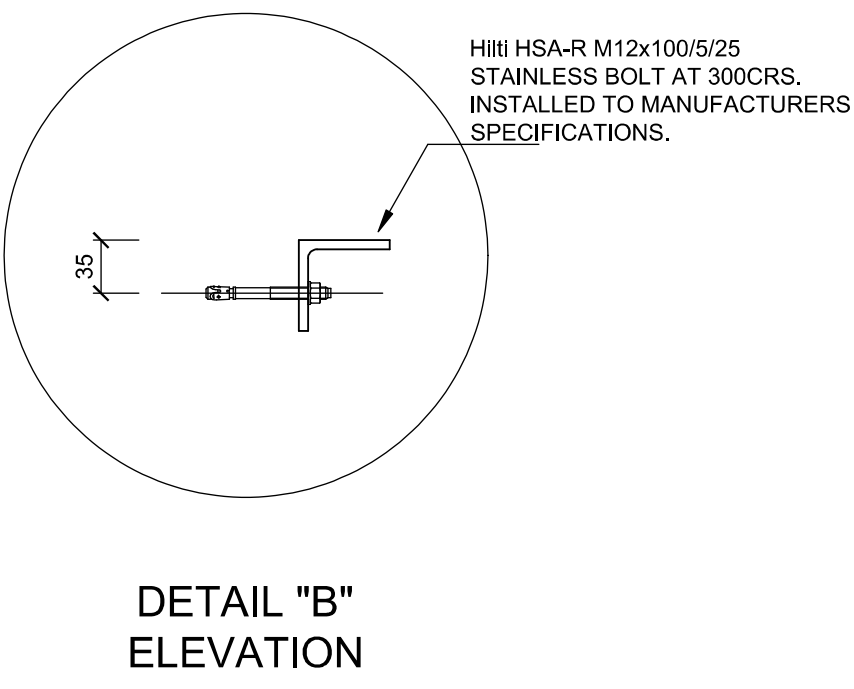


DETAIL "B" ELEVATION

SCALE 1:5

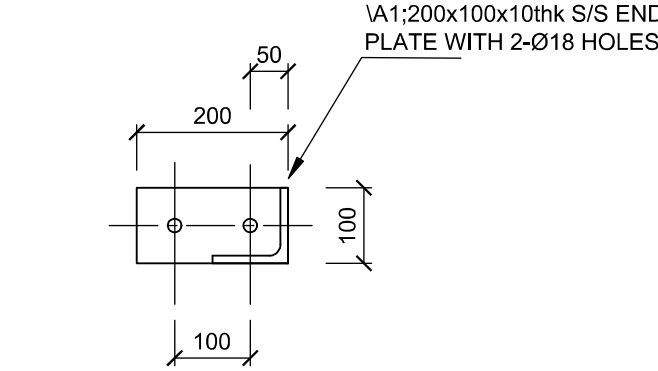


END PLATE DETAILS

SCALE 1:10

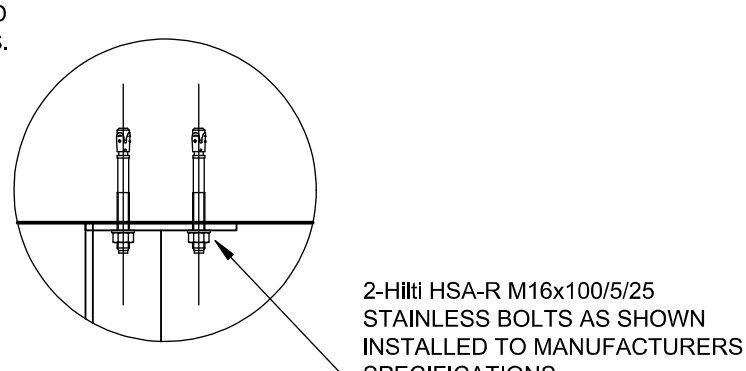


DETAIL "A"


SCALE 1:10

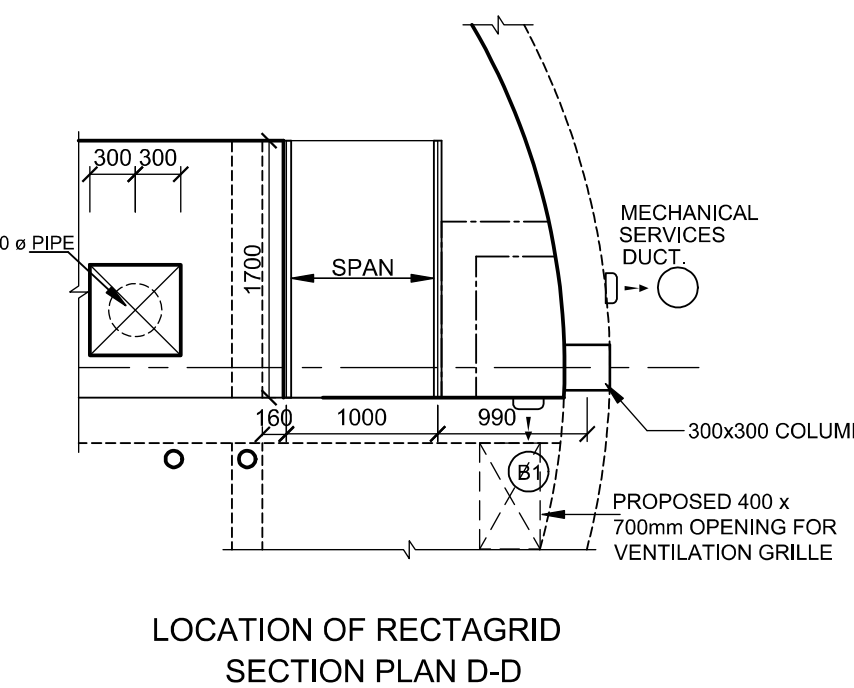


LOCATION OF RECTAGRID SECTION PLAN D-D

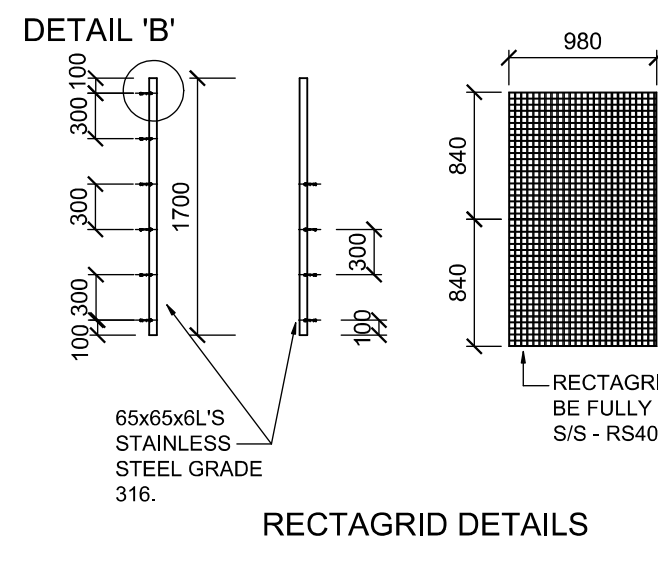


RECTAGRID DETAILS

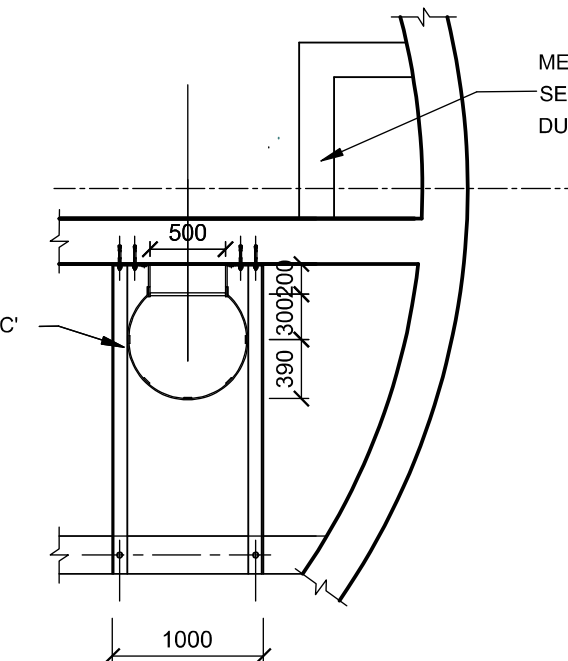

LOCATION OF RECTAGRID SECTION PLAN C-C

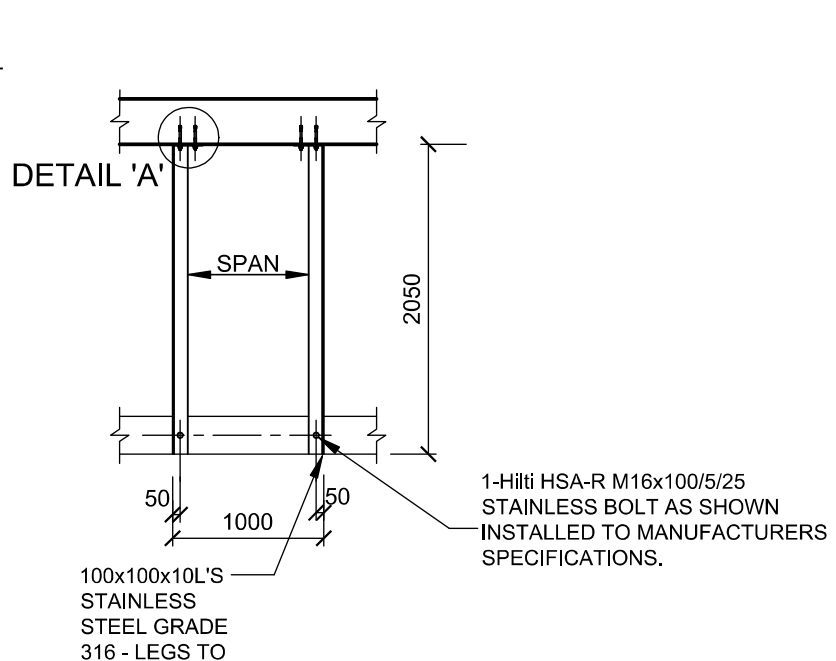


RECTAGRID DETAILS

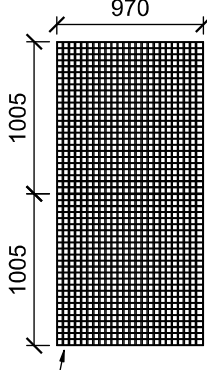

RECTAGRIDS IN PUMPSTATION


SCALE 1:50

RECTAGRIDS IN PUMPSTATION

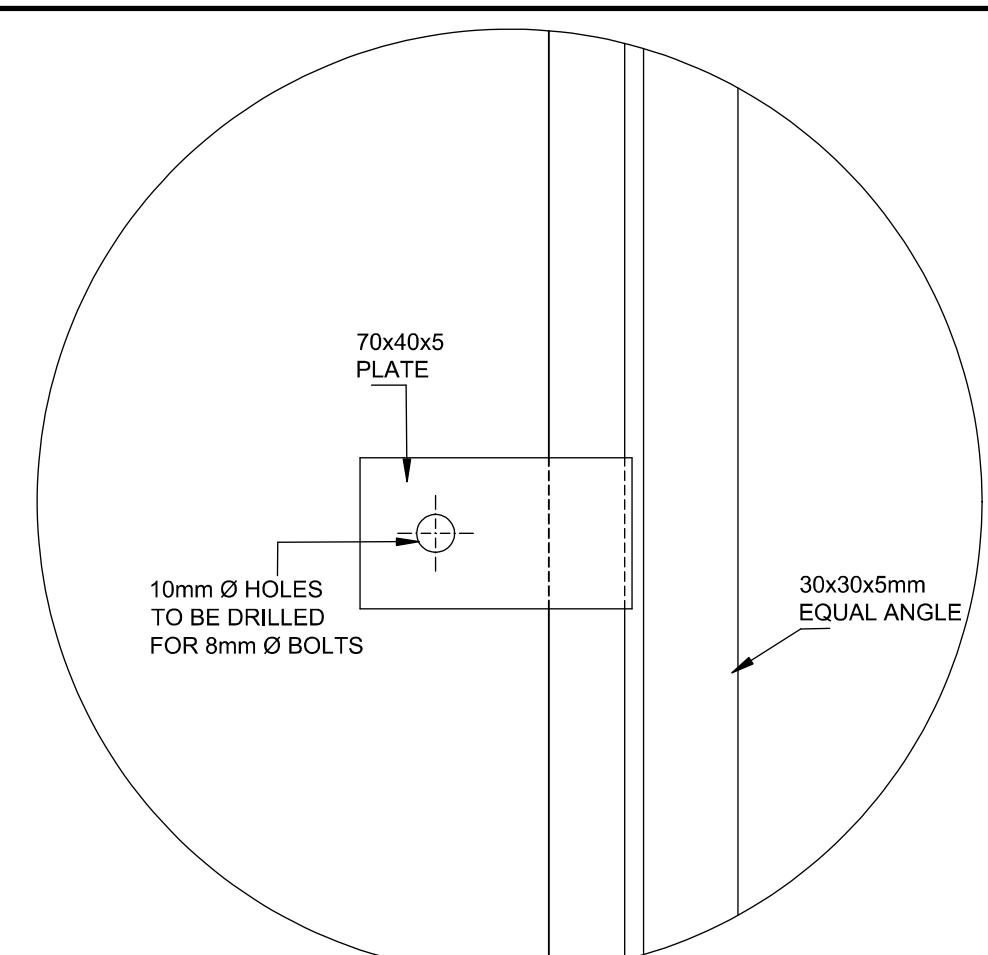


DETAIL 'A' PLAN

SCALE 1:2

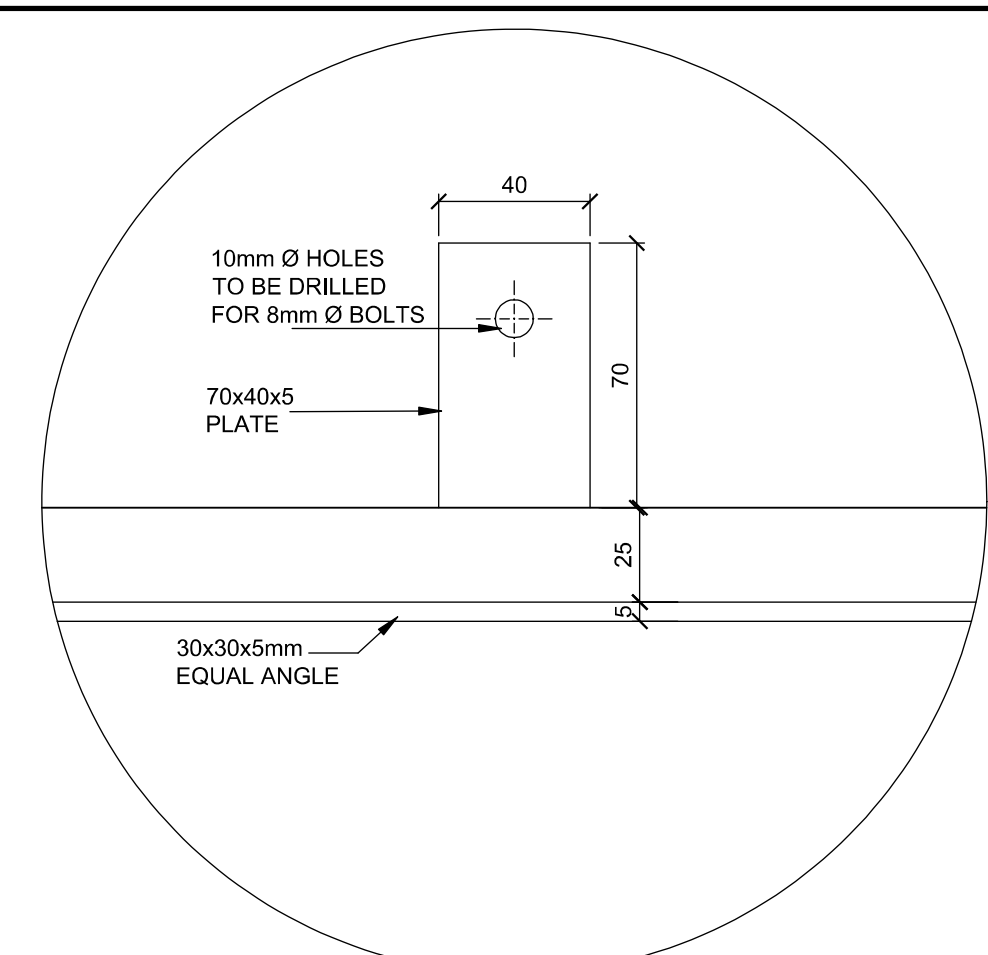


DETAIL 'B' ELEVATION

SCALE 1:2

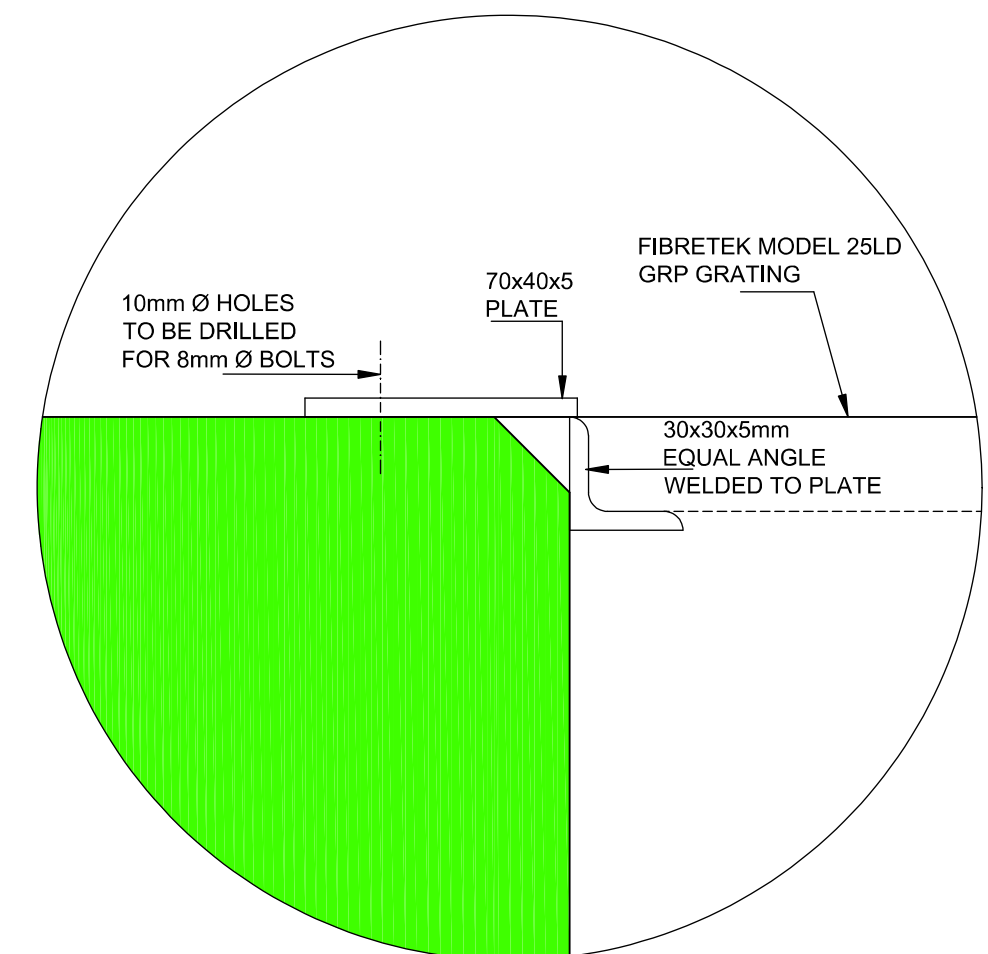

DETAIL 'A' SECTION

SCALE 1:2

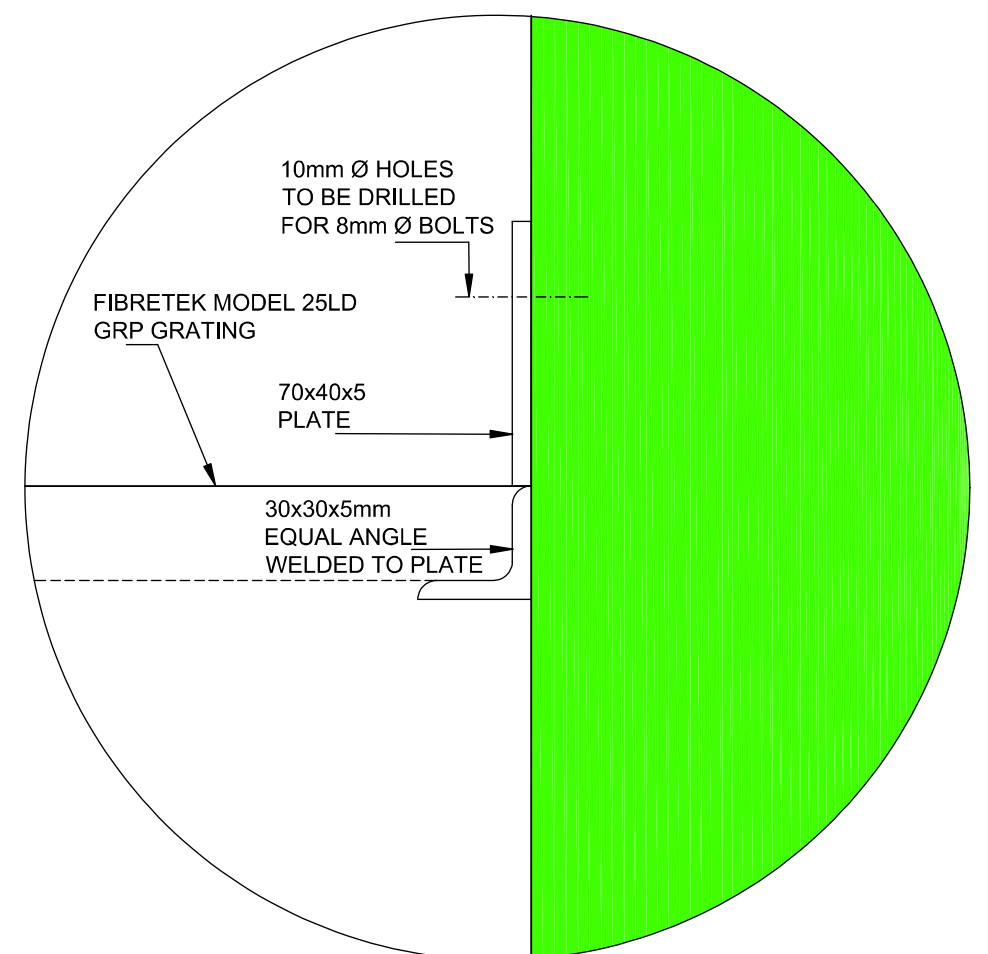

DETAIL 'B' SECTION

SCALE 1:2

NOTE:
1. ALL BOLTS, ANGLES AND PLATES TO BE GRADE 316 STAINLESS STEEL

Z	RECORD DRAWING	PAS	30/03/2012
3	ADDITION RECTAGRID DETAILS FOR DRY WELL	PAS	10-2011
2	ADDITION DETAILS OF RECTAGRID FOR BASE OF LADDER 'A' & 'C', CORRECTION TO SCALE OF TRENCH WIDTHS	PAS	08-2011
1	ISSUED FOR CONSTRUCTION	PAS	07-2011
No	AMENDMENTS	APPR	DATE
SURVEYED	-	FILE	
PLOTTED		SURVEY CHECKED	
DRAWN	CC	DRAWING CHECKED	-
DESIGNED	CC	DESIGN CHECKED	-
PLOT FILE		PLOT SCALE	

PROJECT CONTROLLER

DATE


PROJECT DIRECTOR

DATE

CLIENT/EXTERNAL APPROVAL

FOR

CONSULTING ENGINEER

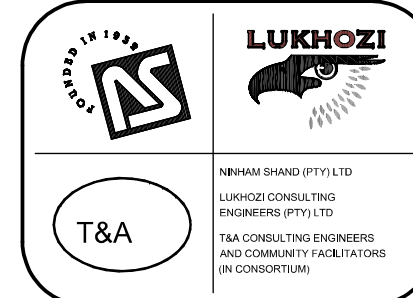

CLIENT



PROPOSED MARICULTURE DEVELOPMENT IN ZONE 1A

CONTRACT 3: CONSTRUCTION OF SALT WATER EXTRACTION WORKS AND PUMP STATION DETAILS AND LAYOUTS OF RECTAGRIDS

SCALE	SHEET 1 OF 1 SHEETS
AS SHOWN	DATE
	OCTOBER 2011
DRAWING No	REVISION
1359/PSN/314	Z