




JETTING ACCESS CHAMBER  
SCALE 1:10

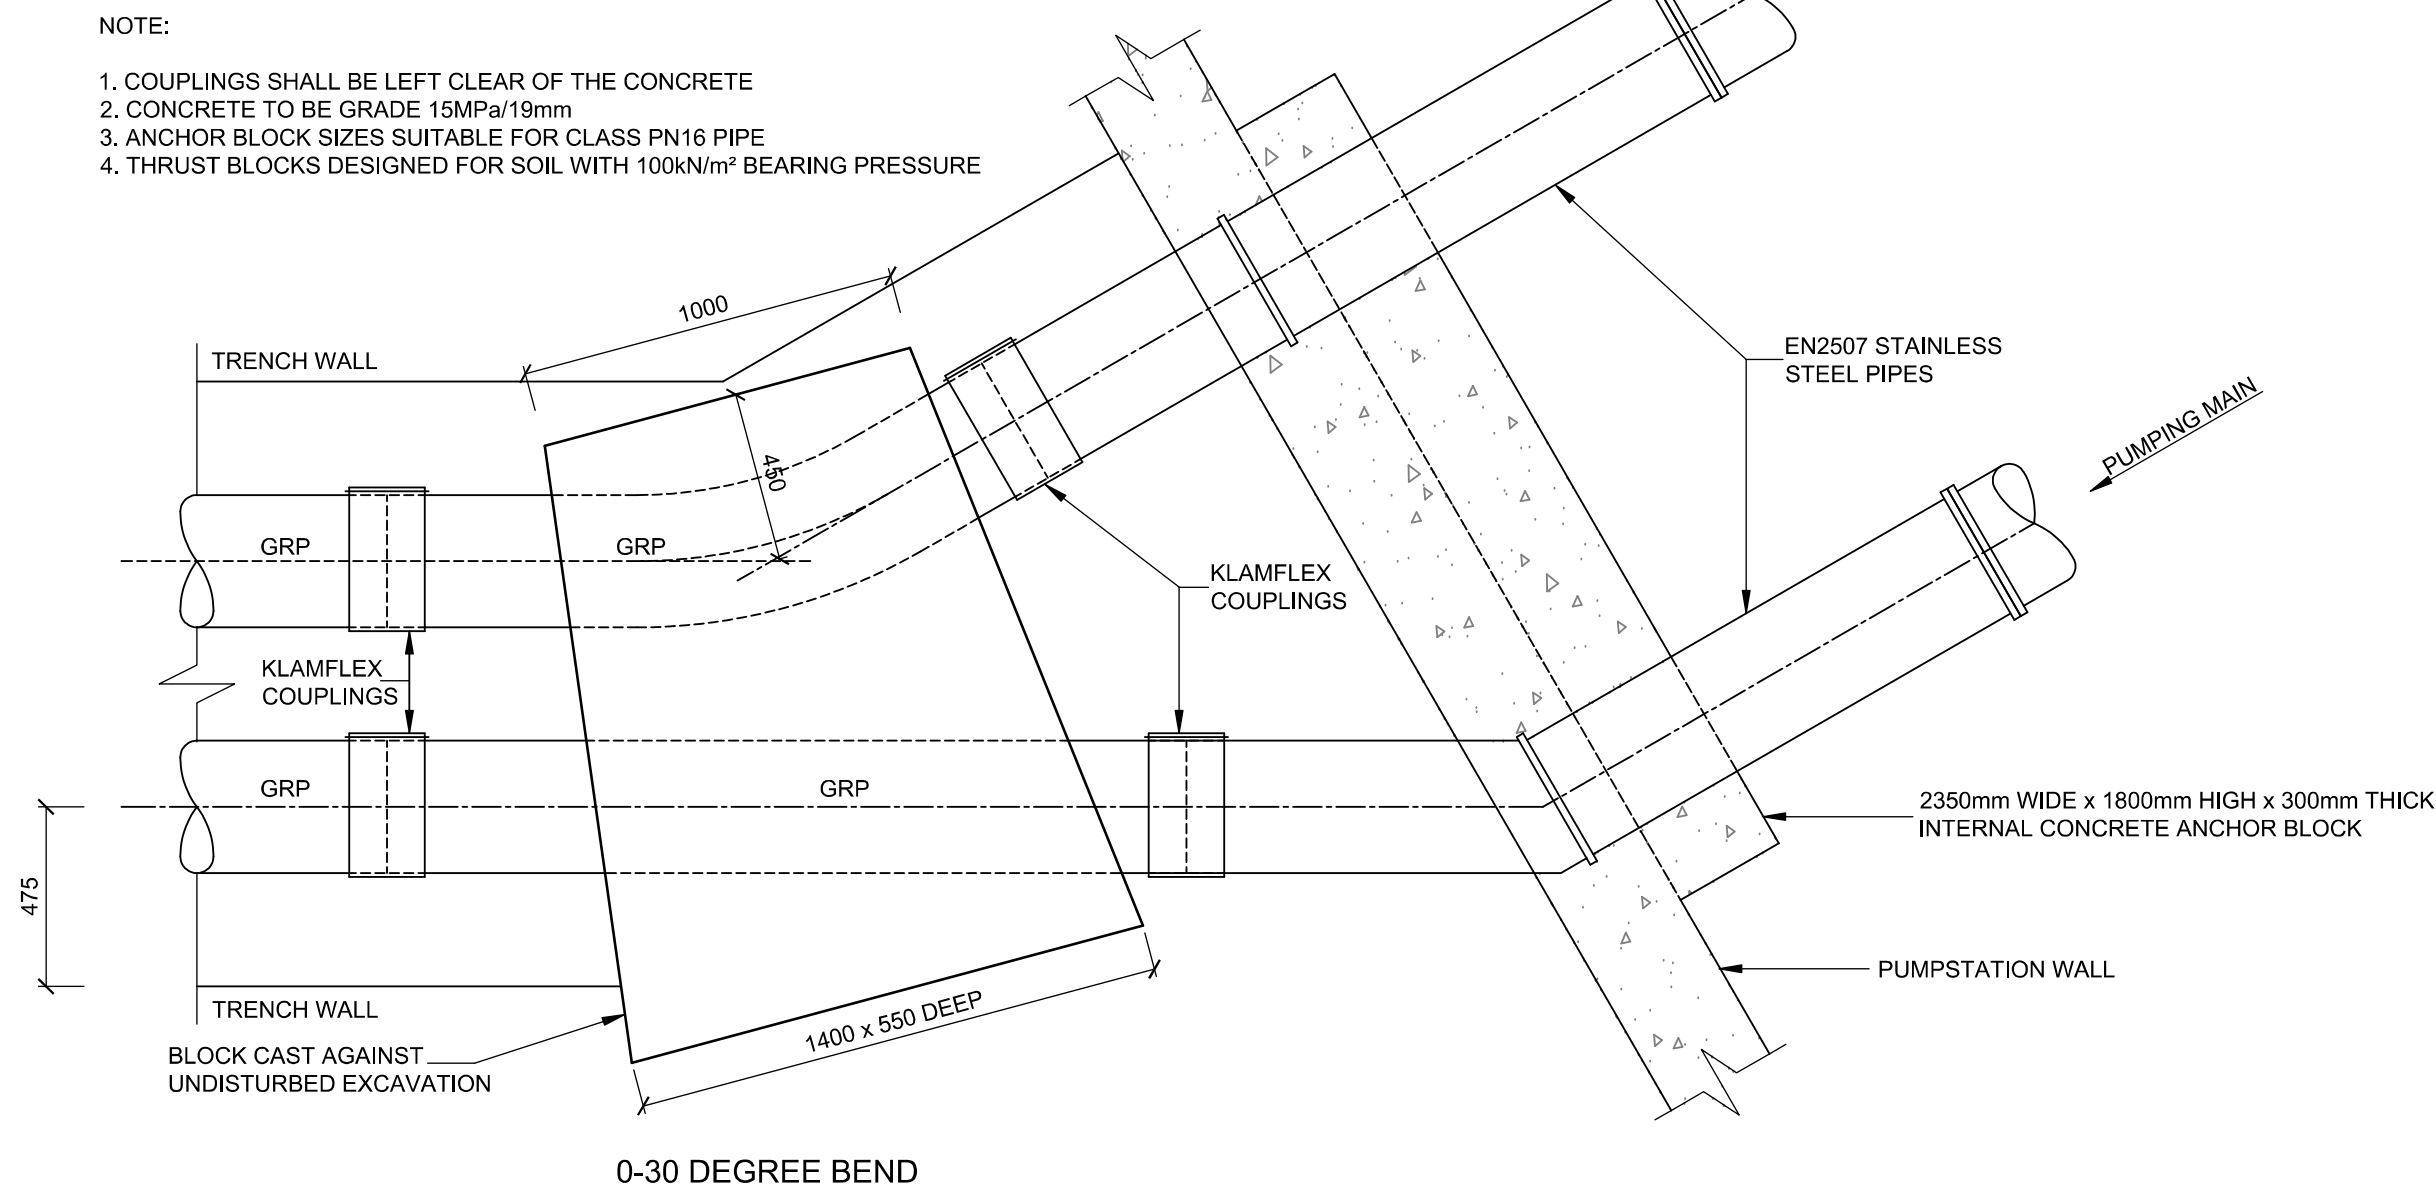

ANCHOR BLOCK FOR 350mm DIAMETER BEND OUTSIDE PUMPSTATION  
SCALE 1:20

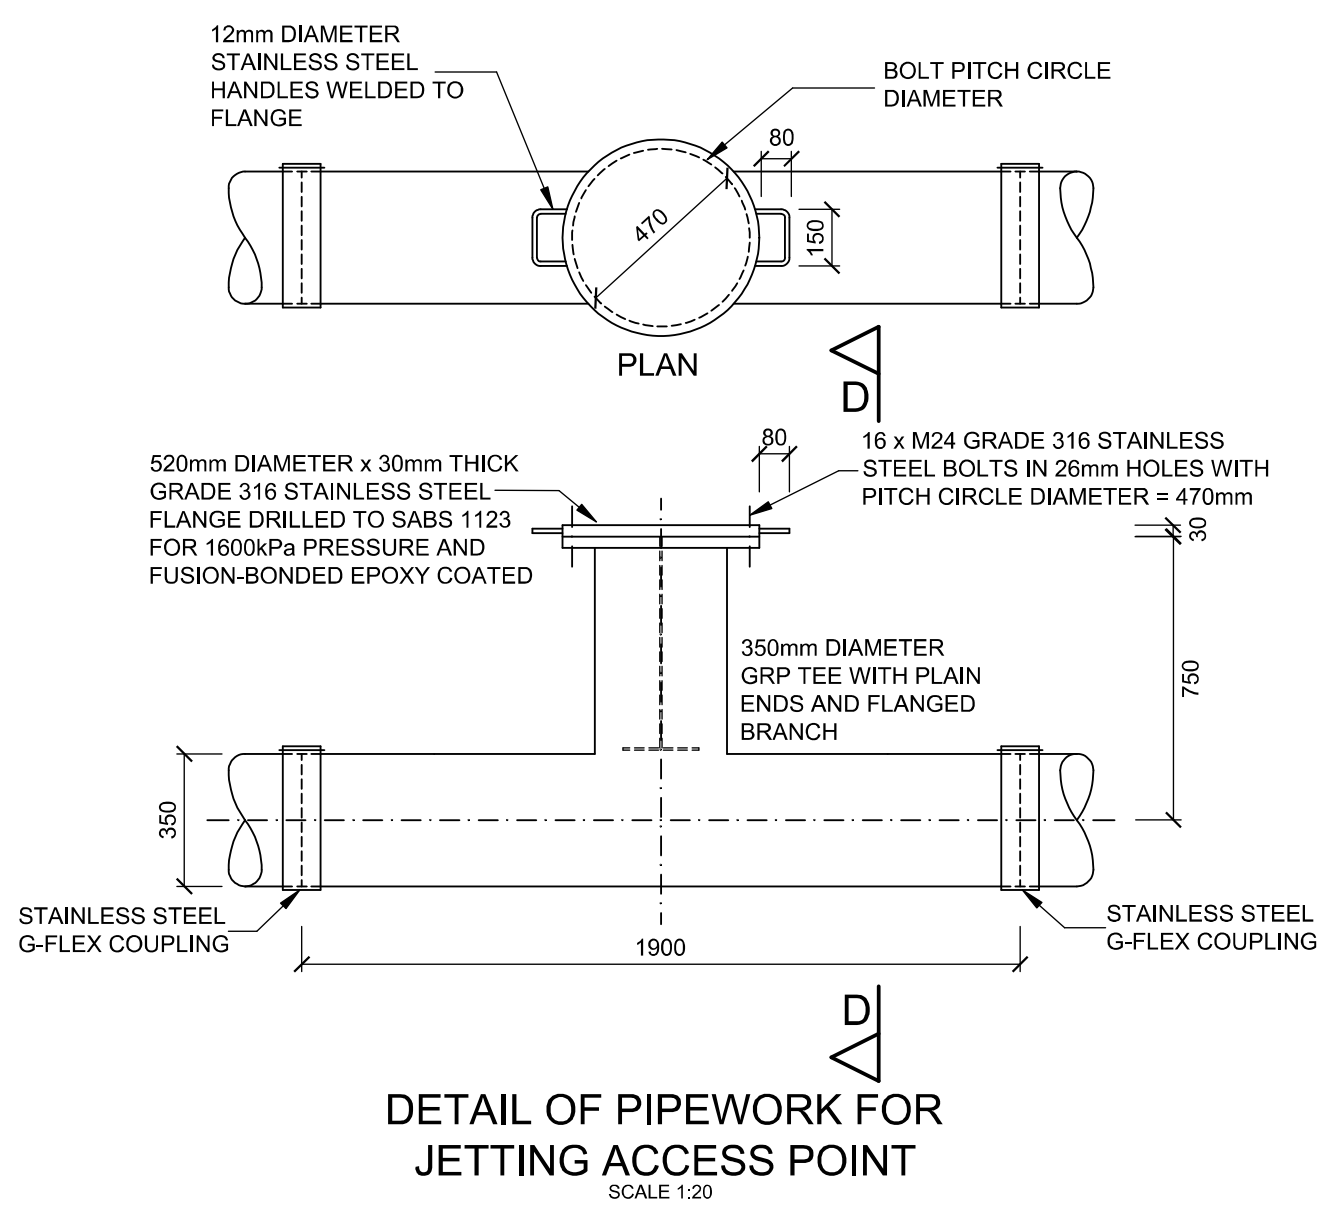

DETAIL OF PIPEWORK FOR  
JETTING ACCESS POINT  
SCALE 1:20

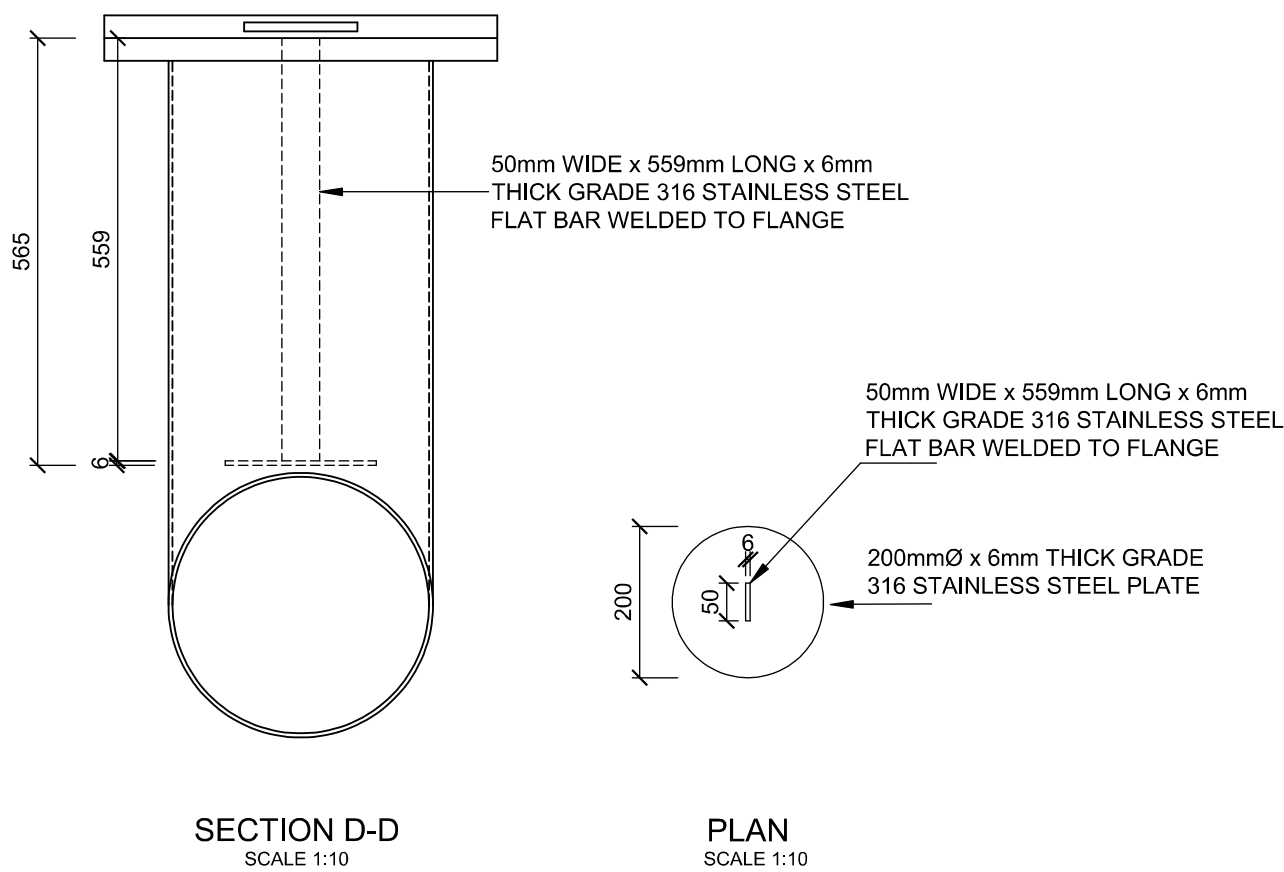

SECTION D-D  
SCALE 1:10

PLAN  
SCALE 1:10

No	AMENDMENTS	APPR.	DATE
1	ISSUED FOR CONSTRUCTION	PAS	03/2011
Z	RECORD DRAWING	PAS	30/03/2012

GENERAL NOTES			DATE
SURVEYED	PFA	-	
DRAWN	CC	PAS	
DESIGNED	PAS	PAS	
CHECKED	PAS	PAS	
APPROVED	-	-	

CONSULTING ENGINEERS:	
CLIENT:	

--

PROPOSED MARICULTURE DEVELOPMENT IN ZONE 1A	
CONTRACT 3: CONSTRUCTION OF SALT WATER EXTRACTION WORKS AND PUMP STATION	
EXTRACTION WORKS AND PIPELINES GENERAL DETAILS (SHEET 2)	
SCALE: AS SHOWN	DATE: MARCH 2011
DRAWING No. 1359/WAT/312	REVISION Z

Dir: File Path: P:\1359\_ELDZ Mariculture\_Zone\Drawings\Record Drawings\CONTRACT 3 - EXTRACTION WORKS AND PUMPSTATION RECORD DRAWING\1359-WAT-312-REV Z General detail Sheet 2.dwg  
Sheet Name: 1359-WAT-312-REV Z