



SECTION H-H  
SCALE 1:25

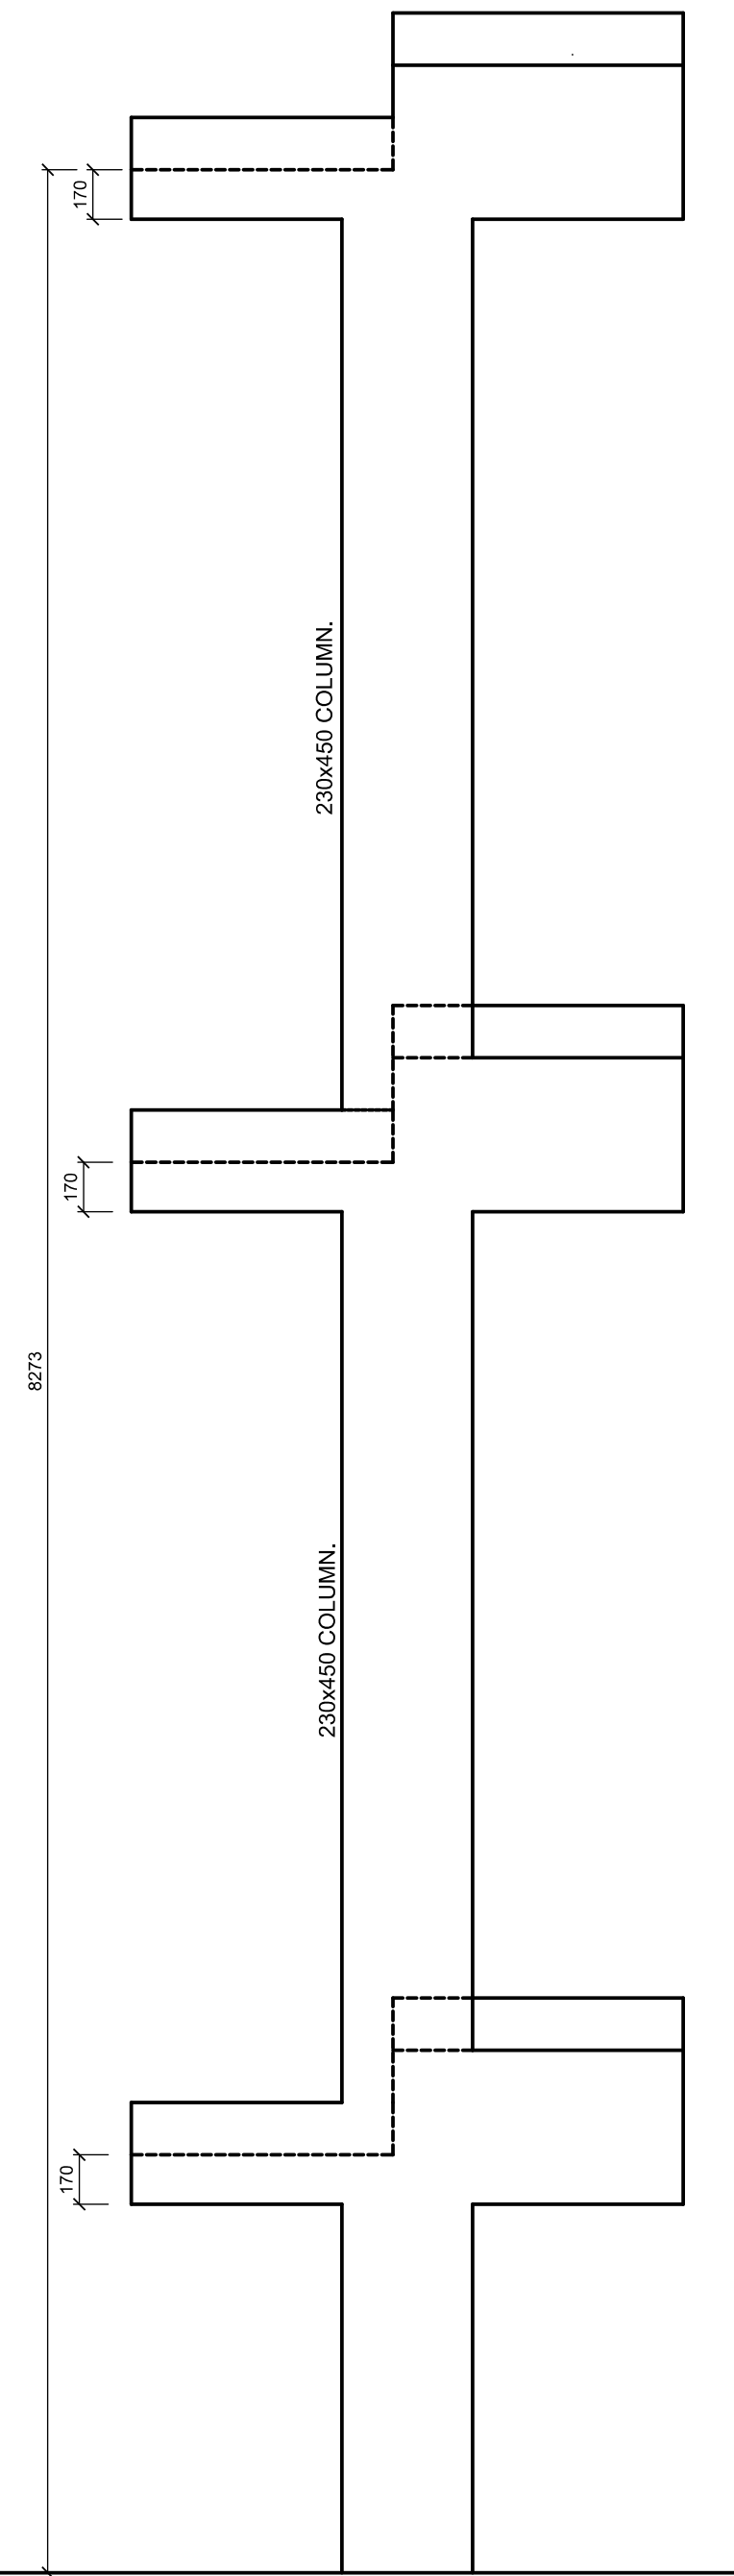


ELEVATION J-J  
SCALE 1:25

CONCRETE STAIRCASE

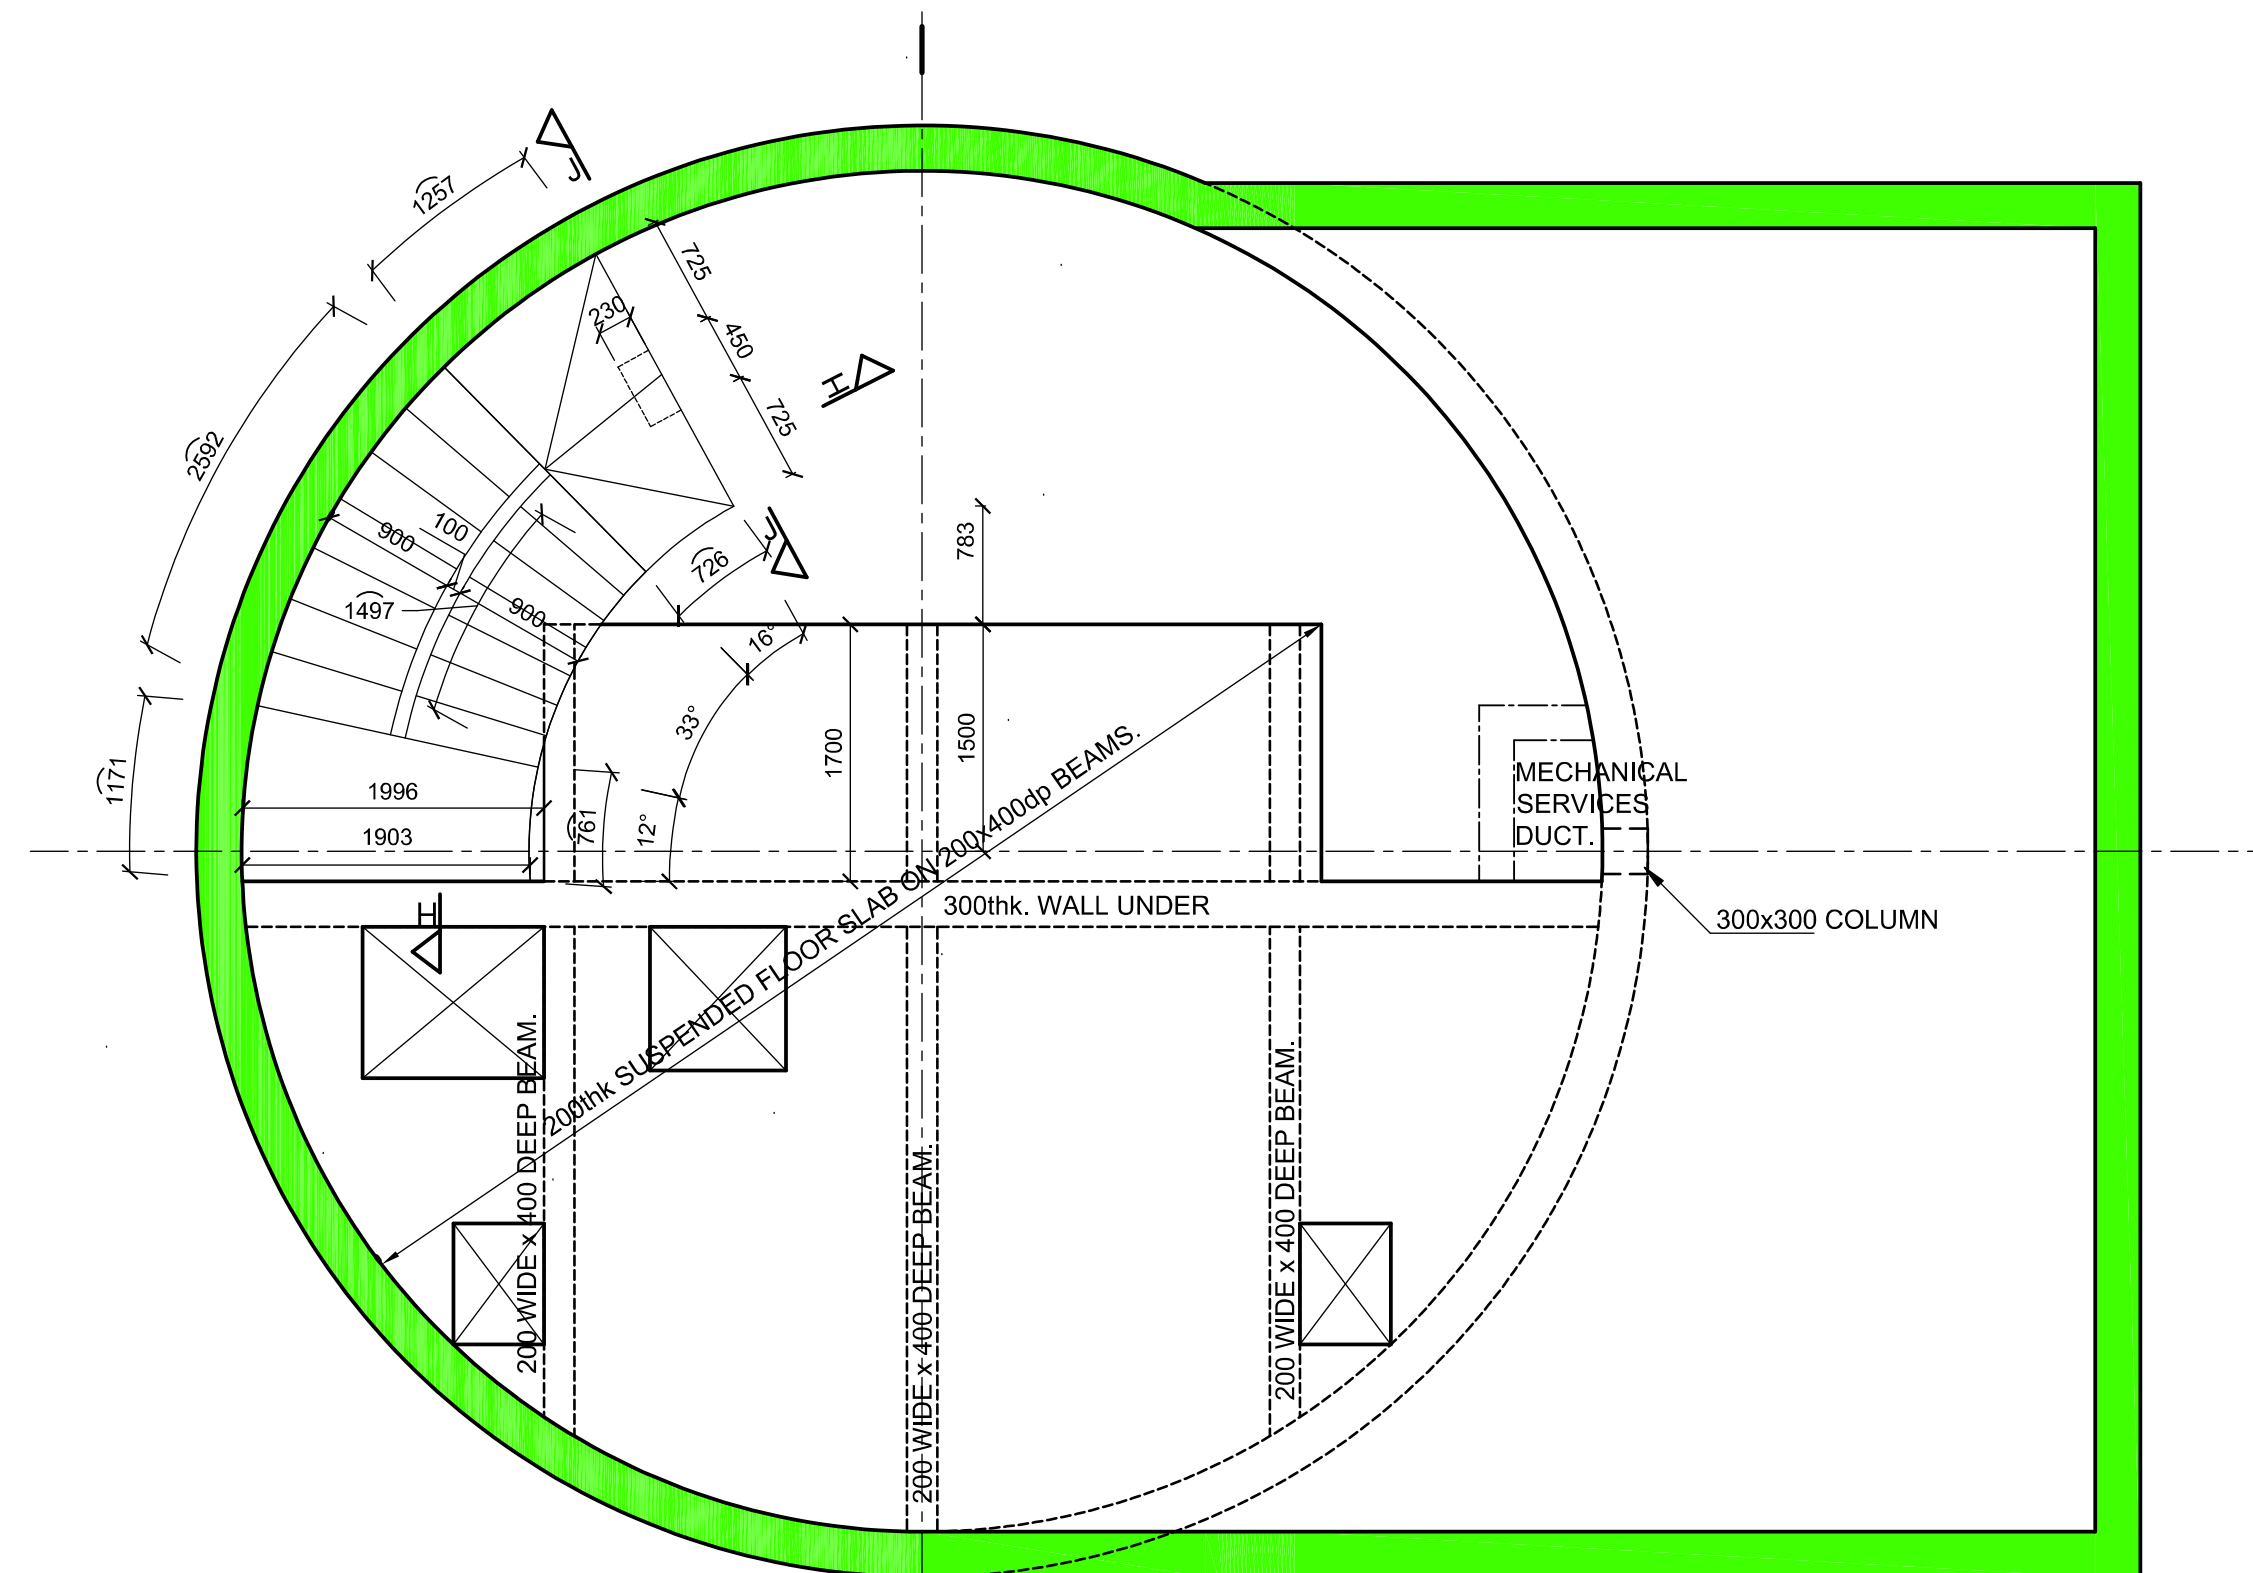

PLAN  
SCALE 1:50

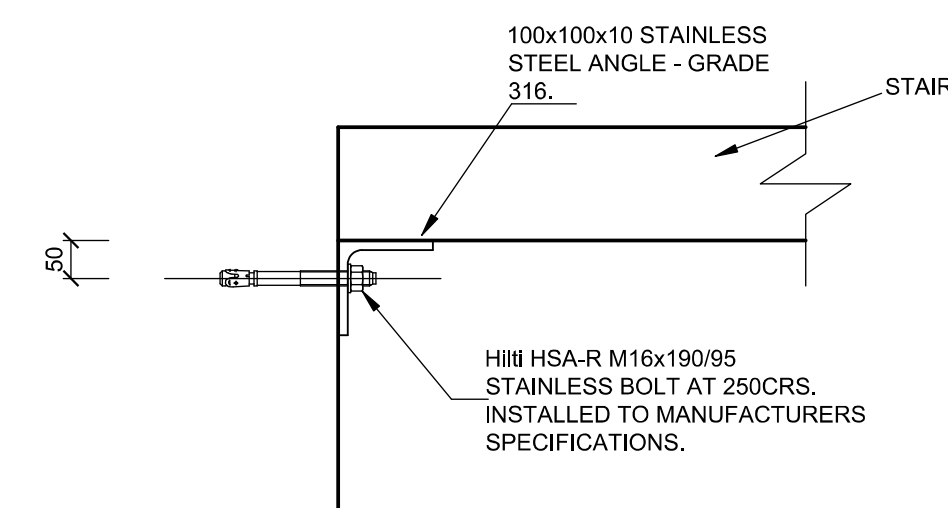

DETAIL 1 OF ANGLES AND BOLTS  
SCALE 1:10

GENERAL NOTES:

1. ALL CONCRETE IN FLOOR, WALLS, SLABS AND ROOF, TO BE 40MPa/19mm WITH MINIMUM CEMENT CONTENT OF 325kg/m<sup>3</sup>.
2. CONCRETE COVER TO REINFORCEMENT TO BE 60mm.
3. NO CONCRETE TO BE POURED UNTIL THE STEEL HAS BEEN INSPECTED BY THE CONSULTING ENGINEER.
4. ANY BREAKS IN THE CONCRETE ARE TO BE MADE IN ACCORDANCE WITH THE ENGINEERS INSTRUCTIONS.
5. NO STRUCTURAL ALTERATIONS TO BE MADE WITHOUT THE APPROVAL OF THE CONSULTING ENGINEER.
6. ALL DIMENSIONS TO BE CHECKED ON SITE BEFORE WORK IS PUT IN HAND. ANY DISCREPANCY MUST IMMEDIATELY BE REPORTED TO THE ENGINEER.
7. THIS DRAWING IS NOT TO BE SCALED.
8. TOP SURFACE OF STAIR TREADS TO BE PROVIDED WITH REEDED FINISH

Z	RECORD DRAWING	PAS	30/03/2012
1	ISSUED FOR CONSTRUCTION	PAS	08-2011
No	AMENDMENTS		APPR. DATE
SURVEYED	-	FILE	
PLOTTED		SURVEY CHECKED	
DRAWN	CC	DRAWING CHECKED	-
DESIGNED	CC	DESIGN CHECKED	-
PLOT FILE		PLOT SCALE	

PROJECT CONTROLLER

DATE

PROJECT DIRECTOR


DATE

CLIENT/EXTERNAL APPROVAL:

FOR:

DATE:

CONSULTING ENGINEERS:

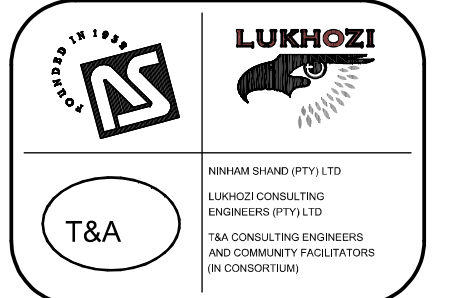

CLIENT:



PROPOSED MARICULTURE  
DEVELOPMENT IN ZONE 1A  
CONTRACT 3: CONSTRUCTION OF  
SALT WATER EXTRACTION WORKS  
AND PUMP STATION  
PUMP STATION CONCRETE  
STAIRCASE

SCALE

1:50

SHEET 1 OF 1 SHEETS

DATE

AUGUST 2011

DRAWING No

1359/PSN/316

REVISION

Z