



SECTION A-A

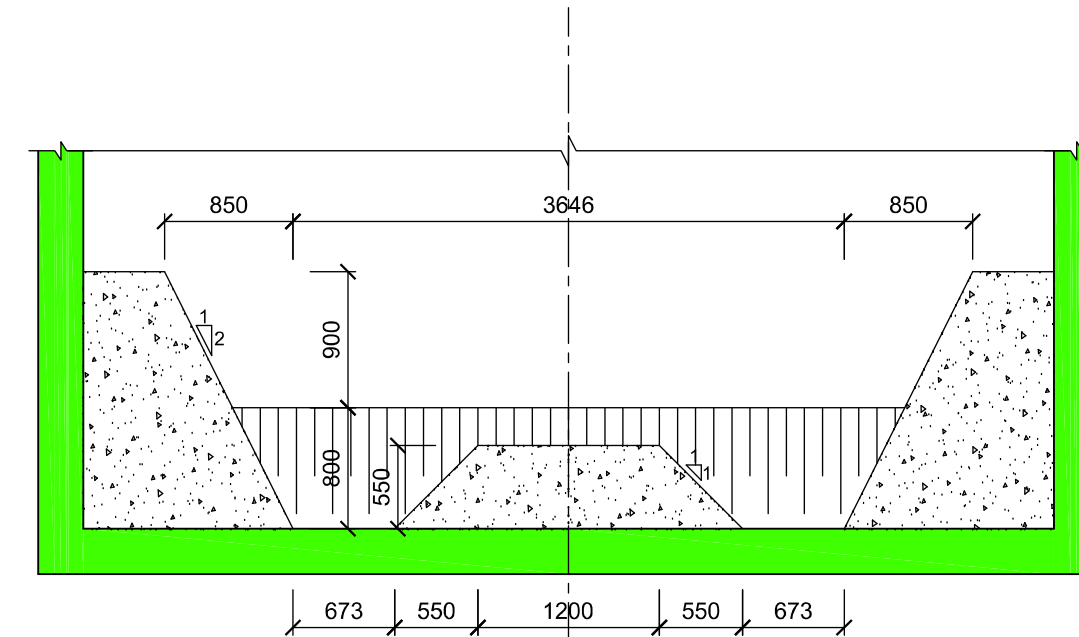

SECTION B-B


BENCHING FOR INLET SUMP

SCALE 1:50

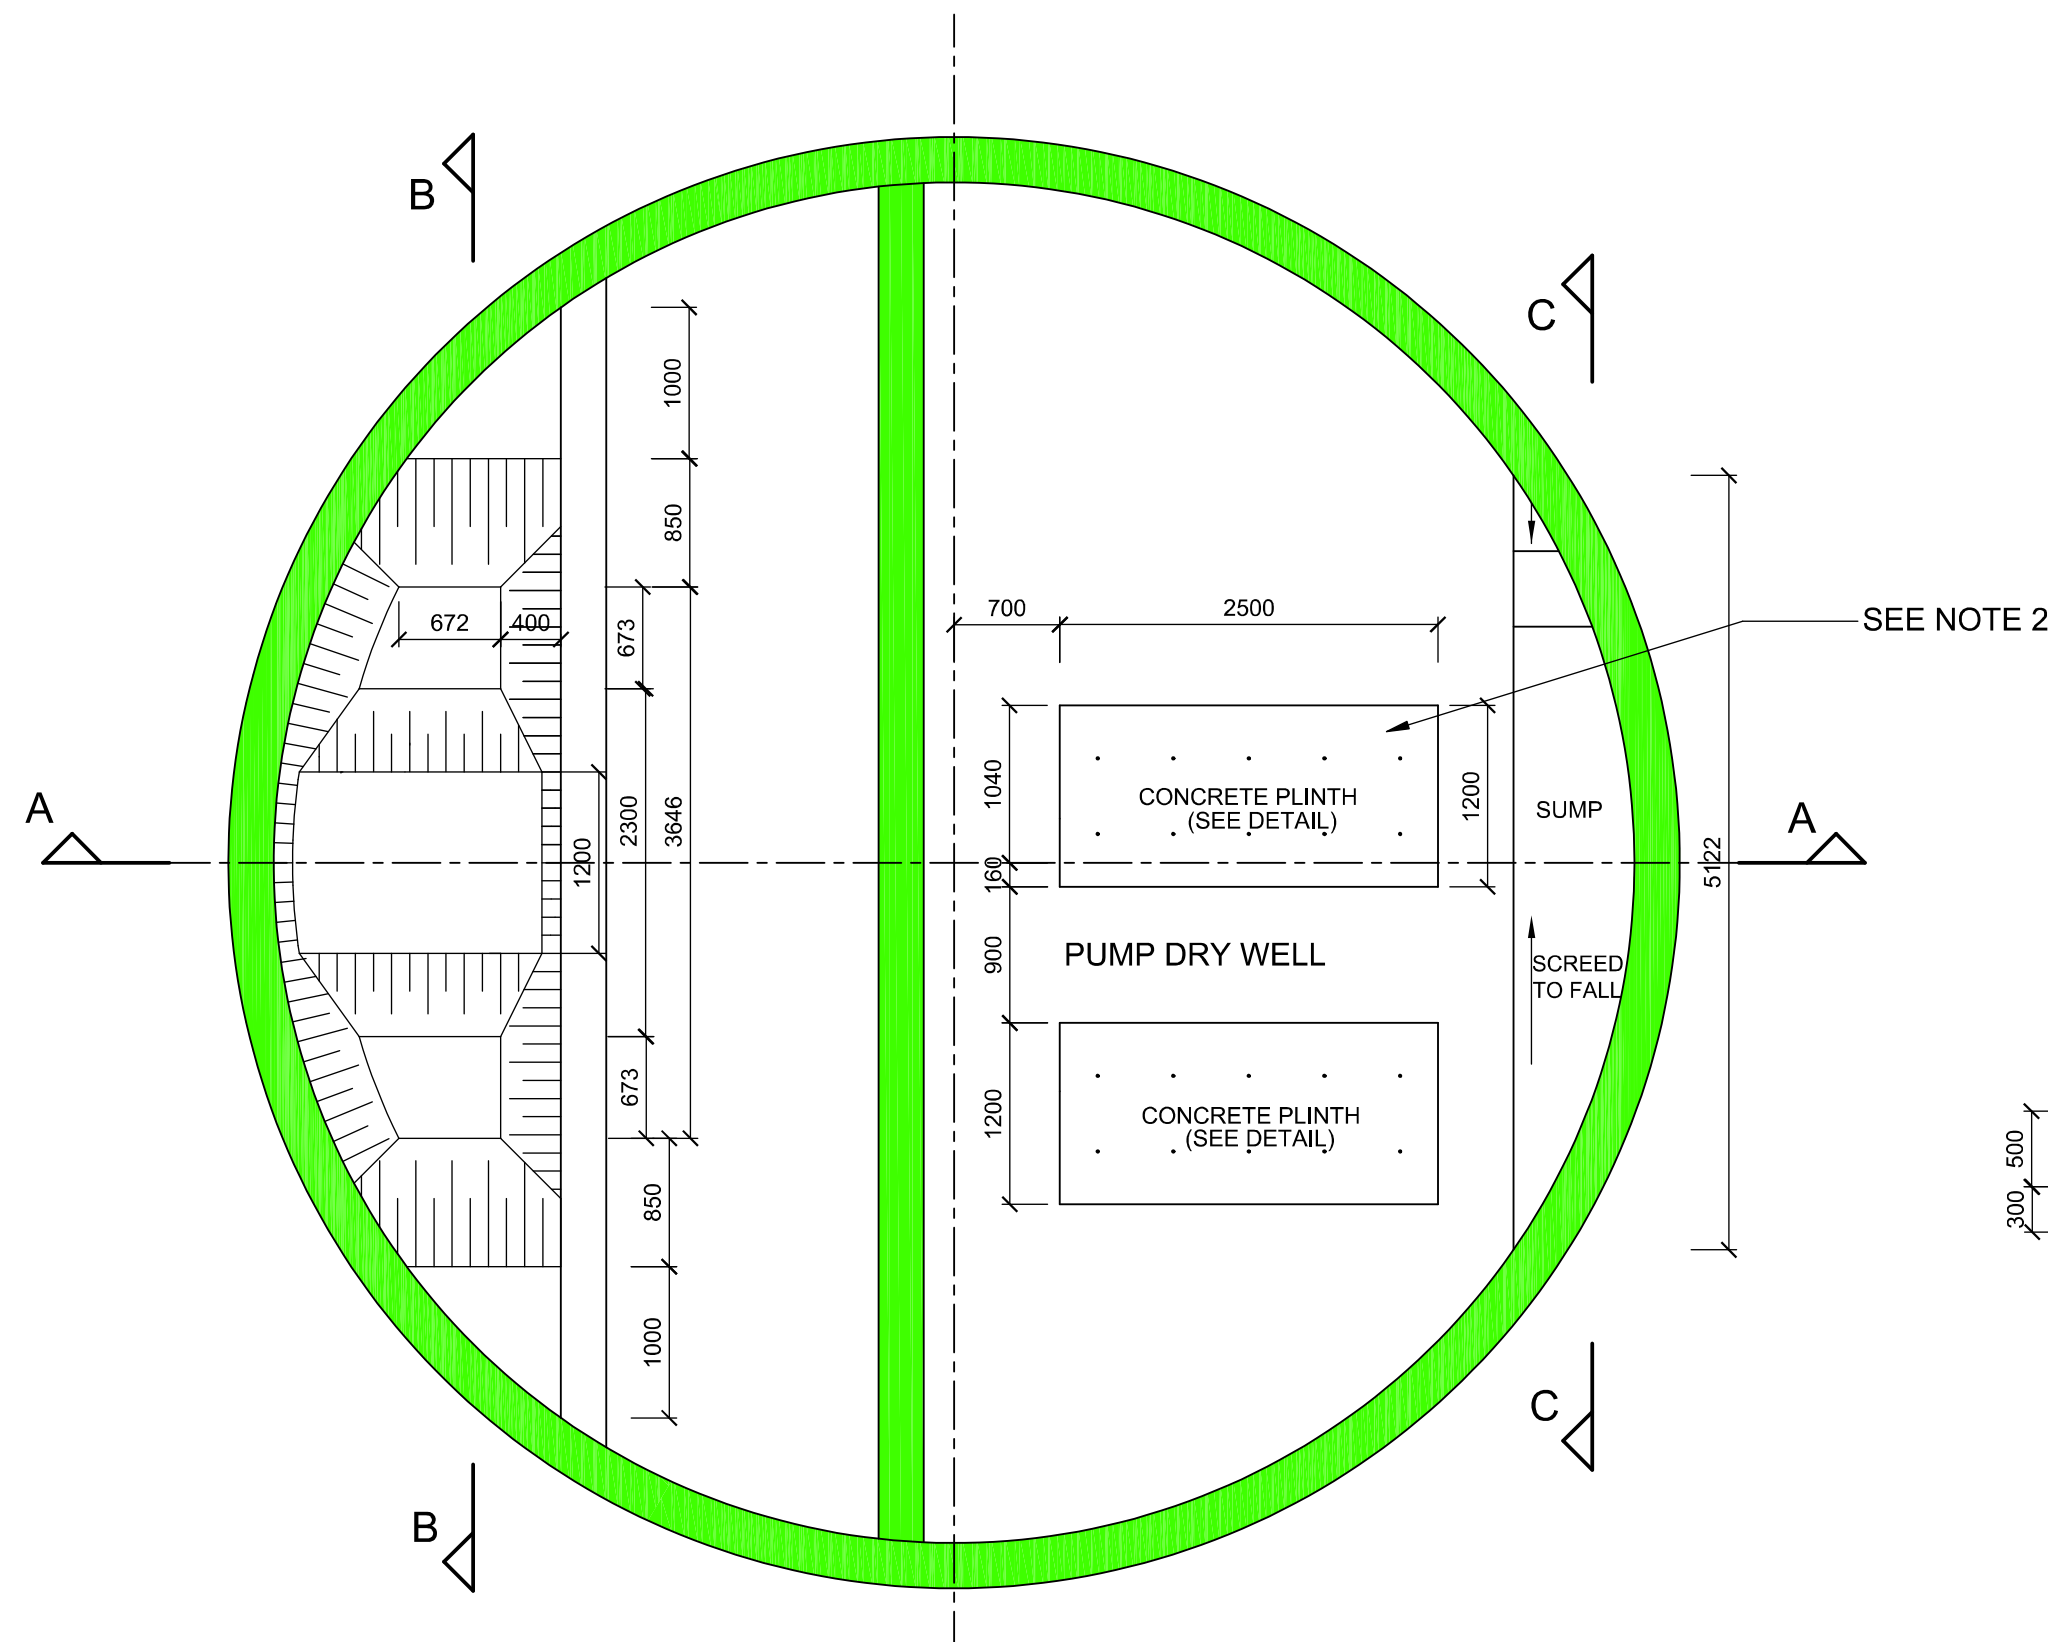


PLAN OF PUMPSTATION FLOOR

SCALE 1:50

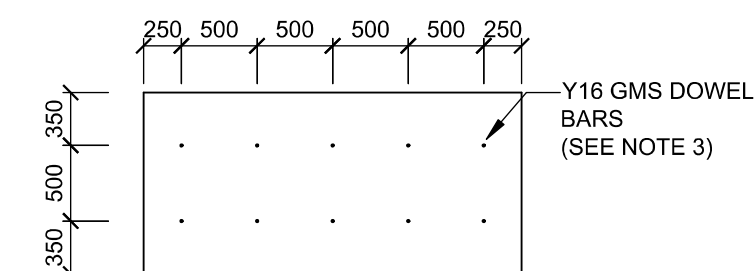

DETAIL OF CONCRETE PLINTH

SCALE 1:50

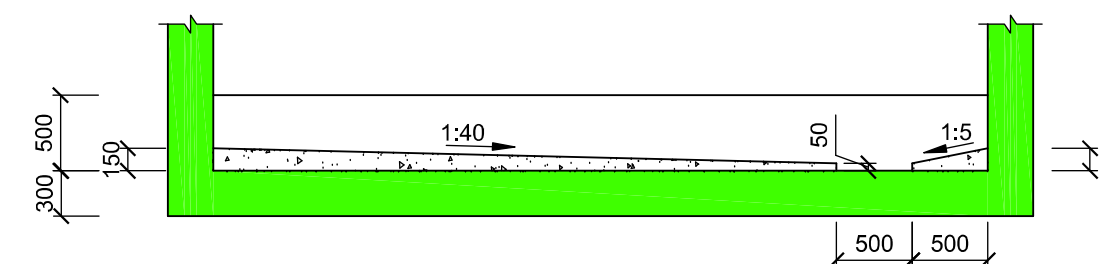

SECTION C-C

BENCHING FOR DRY WELL SUMP

SCALE 1:50

NOTE:

1. ALL CONCRETE IN PLINTHS AND BENCHING TO BE 25MPa/ 19mm.
2. FINAL DETAILS OF PLINTH, PLUS PROCEDURE FOR INSTALLING BOLTS AND PUMPS TO BE AGREED BETWEEN CIVIL CONTRACTOR AND MECHANICAL SUB-CONTRACTOR.
3. 10 NO. Y16 x 300mm LONG GMS BARS TO BE GROUTED INTO BASE SLAB TO A DEPTH OF 150mm, AND SURFACE OF SLAB TO BE PREPARED WITH SIKADUR 32 OR SIMILAR APPROVED EPOXY RESIN BONDING AGENT PRIOR TO CASTING PLINTH.

Z	RECORD DRAWING	PAS	30/03/2012
1	ISSUED FOR CONSTRUCTION	PAS	08-2011
No	AMENDMENTS	APPR.	DATE
SURVEYED	PFA	FILE	
PLOTTED		SURVEY CHECKED	
DRAWN	CC	DRAWING CHECKED	
DESIGNED	PAS	DESIGN CHECKED	
PLOT FILE		PLOT SCALE	

PROJECT CONTROLLER

DATE

PROJECT DIRECTOR


DATE

CLIENT/EXTERNAL APPROVAL:

FOR:

DATE:

CONSULTING ENGINEERS:

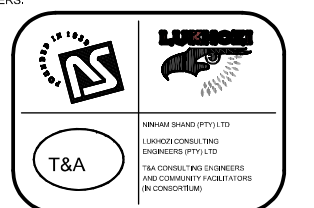

CLIENT:



PROPOSED MARICULTURE DEVELOPMENT IN ZONE 1A

CONTRACT 3: CONSTRUCTION OF SALT WATER EXTRACTION WORKS AND PUMP STATION

DETAILS OF PUMP PLINTHS AND BENCHING TO SUMPS

SCALE

1:50

SHEET 1 OF 1 SHEETS

DATE

AUGUST 2011

DRAWING No

1359/PSN/313

REVISION

Z