

NOTE:  
1. ALL FRAME AND LID COMPONENTS TO BE GRADE 316 STAINLESS STEEL.  
2. FRAME TO BE FIXED TO CONCRETE WITH 8 NO. 8mm x 80mm LONG CHEMICALLY ANCHORED BOLTS.  
3. DIMENSIONS OF OPENINGS TO BE CONFIRMED ON SITE BEFORE FABRICATION.

|           |                         |                 |            |
|-----------|-------------------------|-----------------|------------|
| Z         | RECORD DRAWING          | PAS             | 30/03/2012 |
| 1         | ISSUED FOR CONSTRUCTION | PAS             | 09-2011    |
| No        | AMENDMENTS              | APPR.           | DATE       |
| SURVEYED  | +                       | FILE            |            |
| PLOTTED   | +                       | SURVEY CHECKED  |            |
| DRAWN     | CC                      | DRAWING CHECKED | +          |
| DESIGNED  | PS                      | DESIGN CHECKED  | +          |
| PLOT FILE |                         | PLOT SCALE      |            |

PROJECT CONTROLLER


PROJECT DIRECTOR

CLIENT/EXTERNAL APPROVAL

FOR:

DATE:

CONSULTING ENGINEER

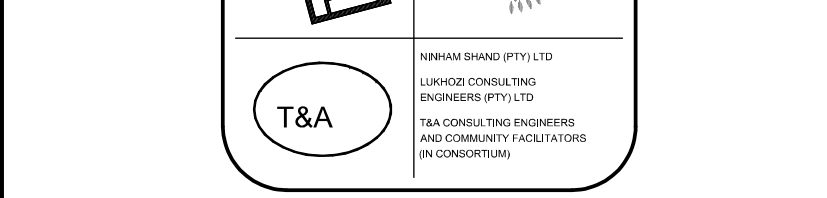

CLIENT



PROPOSED MARICULTURE DEVELOPMENT IN ZONE 1A  
CONTRACT 3: CONSTRUCTION OF SALT WATER EXTRACTION WORKS AND PUMP STATION

DETAILS OF WET WELL COVERS

|                            |   |
|----------------------------|---|
| SCALE<br>AS SHOWN          | SHEET 1 OF 1 SHEETS<br>DATE<br>SEPTEMBER 2011 |
| DRAWING No<br>1359/PSN/315 | REVISION<br>Z                                 |