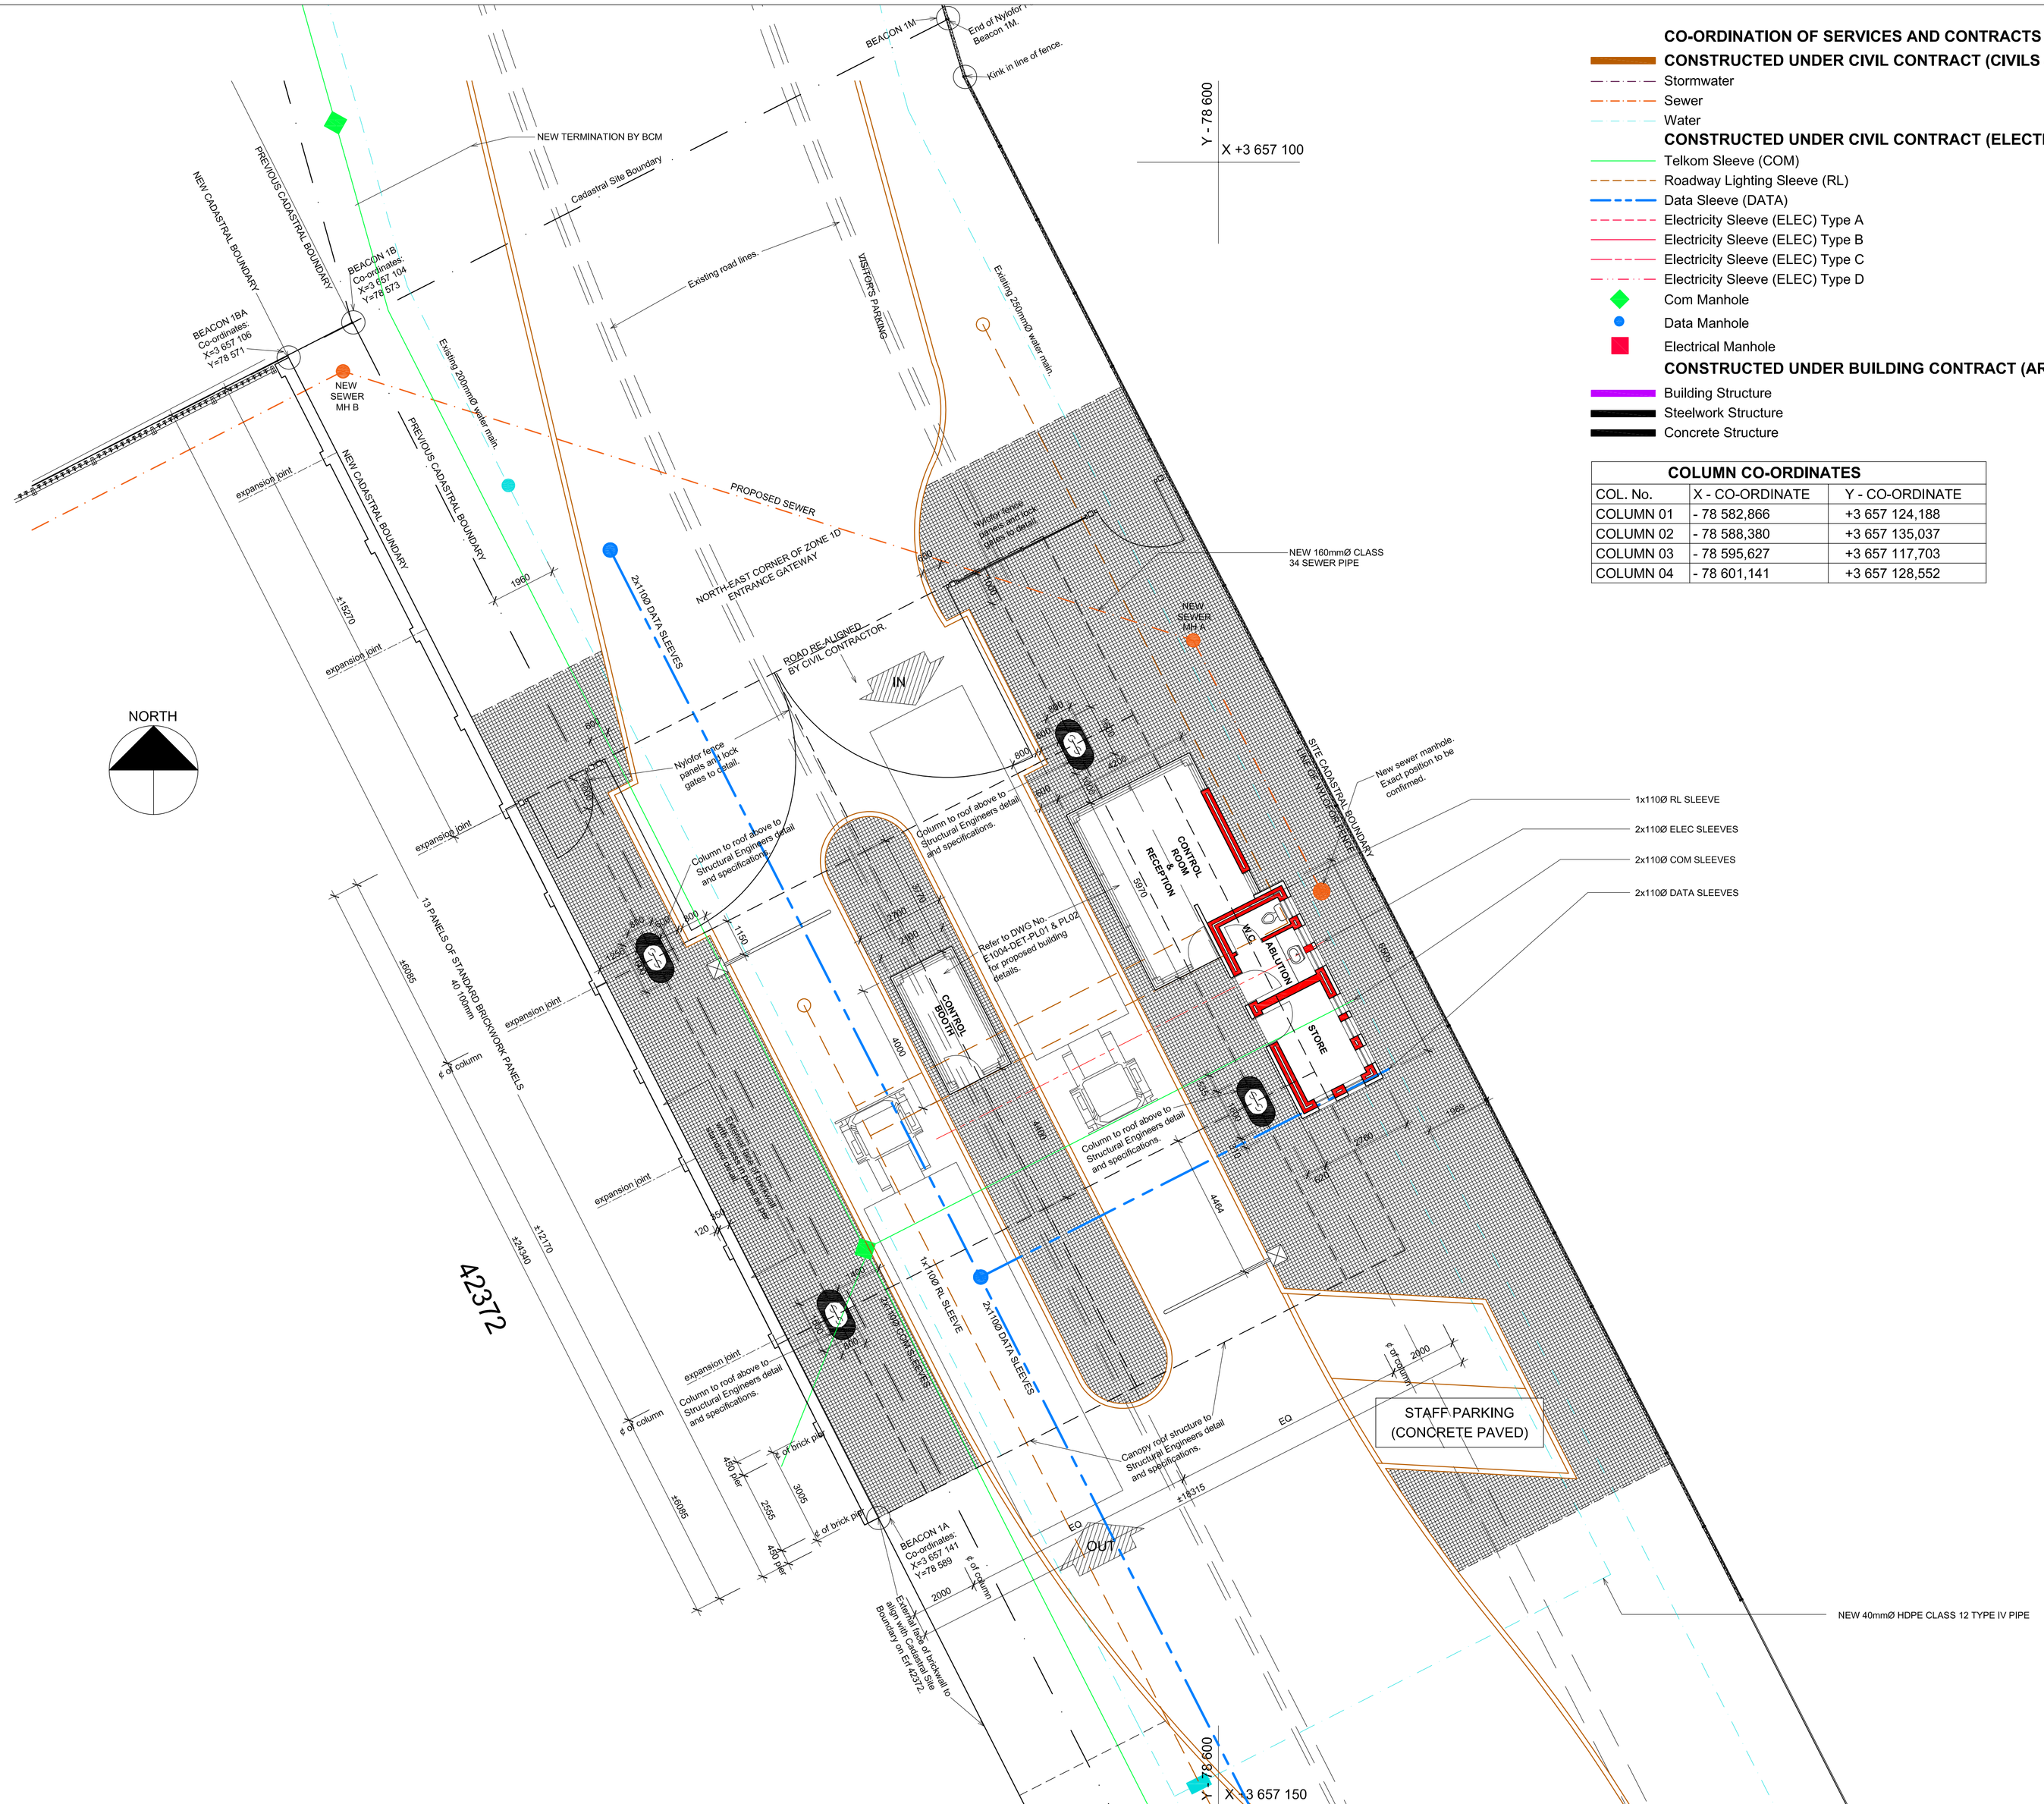

CO-ORDINATION OF SERVICES AND CONTRACTS LEGEND

CONSTRUCTED UNDER CIVIL CONTRACT (CIVILS & ROADWORKS)

- Stormwater
- Sewer
- Water

CONSTRUCTED UNDER CIVIL CONTRACT (ELECTRICAL & DATA SERVICES)

- Telkom Sleeve (COM)
- Roadway Lighting Sleeve (RL)
- Data Sleeve (DATA)
- Electricity Sleeve (ELEC) Type A
- Electricity Sleeve (ELEC) Type B
- Electricity Sleeve (ELEC) Type C
- Electricity Sleeve (ELEC) Type D
- Com Manhole
- Data Manhole
- Electrical Manhole

CONSTRUCTED UNDER BUILDING CONTRACT (ARCHITECTURAL)

- Building Structure
- Steelwork Structure
- Concrete Structure

COLUMN CO-ORDINATES		
COL. No.	X - CO-ORDINATE	Y - CO-ORDINATE
COLUMN 01	- 78 582,866	+3 657 124,188
COLUMN 02	- 78 588,380	+3 657 135,037
COLUMN 03	- 78 595,627	+3 657 117,703
COLUMN 04	- 78 601,141	+3 657 128,552

NOTES

ALL DIMENSIONS AND LEVELS ARE TO BE VERIFIED ON SITE PRIOR TO COMMENCING, SETTING OUT, WORKSHOP DRAWINGS OR CONSTRUCTION

FIGURED DIMENSIONS ONLY TO BE USED, DRAWINGS ARE NOT TO BE SCALED

DISCREPANCIES, ERRORS AND OMISSIONS ARE TO BE BROUGHT TO THE ARCHITECTS ATTENTION IMMEDIATELY THEY BECOME EVIDENT

SHOP DRAWINGS TO BE SUBMITTED FOR APPROVAL PRIOR TO MANUFACTURE OR INSTALLATION

COPYRIGHT AND RIGHT OF REPRODUCTION OF THIS DRAWING OR ANY PORTION THEREOF IS RESERVED BY THE ARCHITECTS

REV.	DATE	DESCRIPTION
A	08/11/2004	-
B	14/01/2008	AS BUILT

AS BUILT
2007 - 12 - 11

IDZ EAST LONDON

Client
EAST LONDON IDZ (PTY) LTD

P. NGCUKA JOINT VENTURE
OSMOND LANGE ARCHITECTS & PLANNERS JOINT VENTURE
1ST FLOOR PILOT MILL HOUSE, THE QUARRY, SELBORNE, EAST LONDON
T (043 721 0033
F (043 721 0035 E) obo-sha@telkomsa.net

Project
EAST LONDON INDUSTRIAL DEVELOPMENT ZONE ZONE 1D

Title
ZONE 1D ENTRANCE CANOPY PLAN

Scale	Date	Drawn	Checked
1:100	08.11.2004	Zuks	A.V.P.

Description
CANOPY PLAN LAYOUT

DRAWING No
E1004/09-CAN-PL01

REVISION
B